

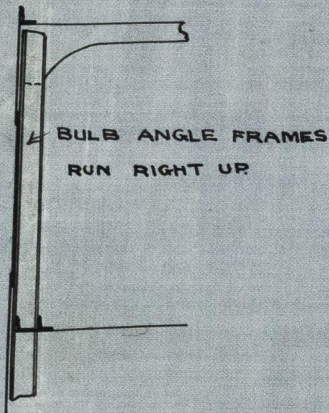


28/9/91.
 18.40.91.
 17.10.91.
 20.10.91.
 SS No 186. SS No 187.

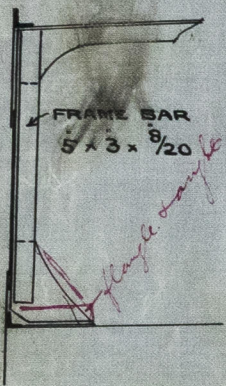

SCALE $\frac{1}{4} = 1 \text{ FOOT}$

Beams, stringer & deck, as shown on sketch of Messing Jackson 25/9/91

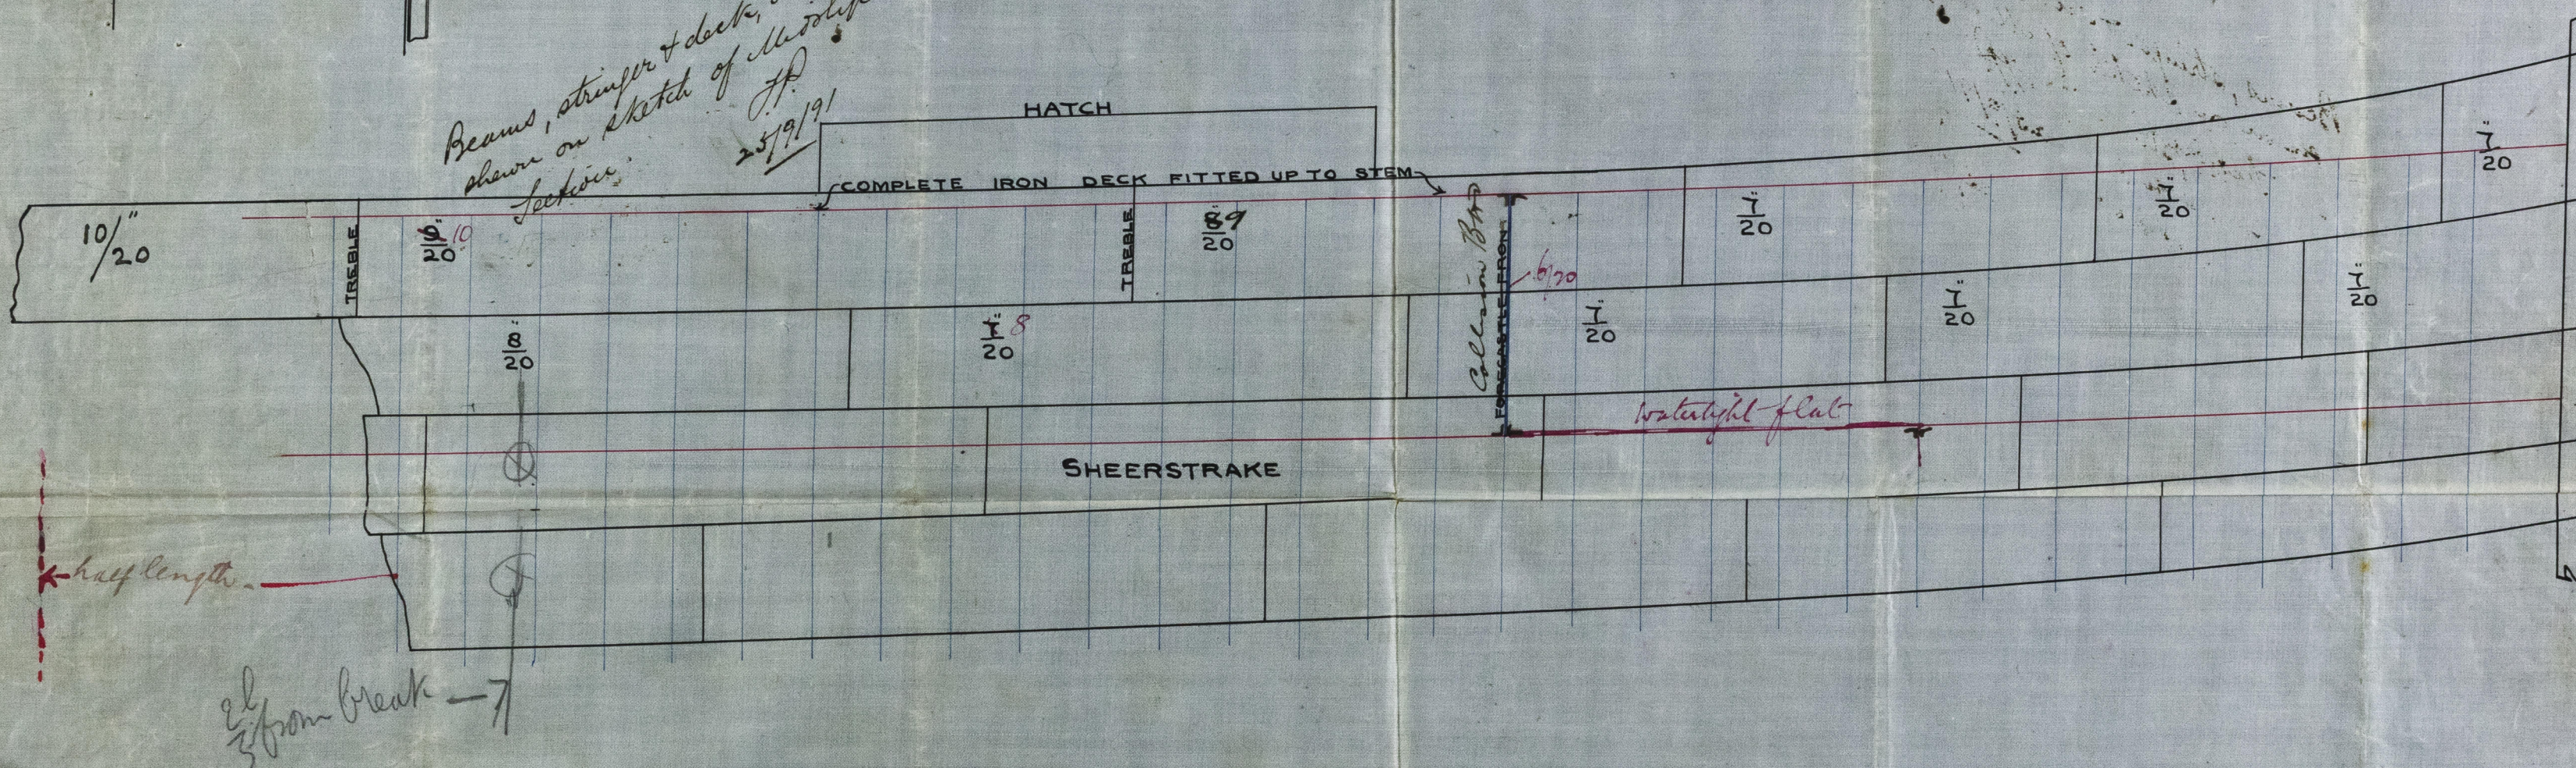

N^{OS} 186 & 7

EDWD. WITBY & CO.
 IRON & STEEL SHIP BUILDERS.
 SHIP REPAIRERS & CO.
 WEST HARTLEPOOL.
 SEPT^R 19TH 1891

HPL 366-0113

Furness, Withy & Co.

Nos 186 & 189.

No 186 - S.S. "Zanni Stepanovich",
H. Hpl. 1st Entry Report No. 8624

Also Marietta Palli
Hpl. 8666

SEPT 13 1893
WEST HARTLEY

SHIP REPAIRS

IRON & STEEL SHIP

EDWARD MICH

No 186

of the firm from -

*red pencil



© 2019

Lloyd's Register
Foundation