

14-5-91

Working Pressure = 160 lbs

Lloyd's rule $260 \times 193 \times 83 = 164$ lbs
144.76


% of rivets 83.6
Top of Plate 83
Bottom 108

1/2" Shell Plates
1/2" Outside Butt Straps
1/2" Inside " "

J. J. Marietta Halli
Lundeland report
No 16330

SCOTIA ENGINE WORKS BOILER


SCALE: 1 INCH TO ONE FOOT

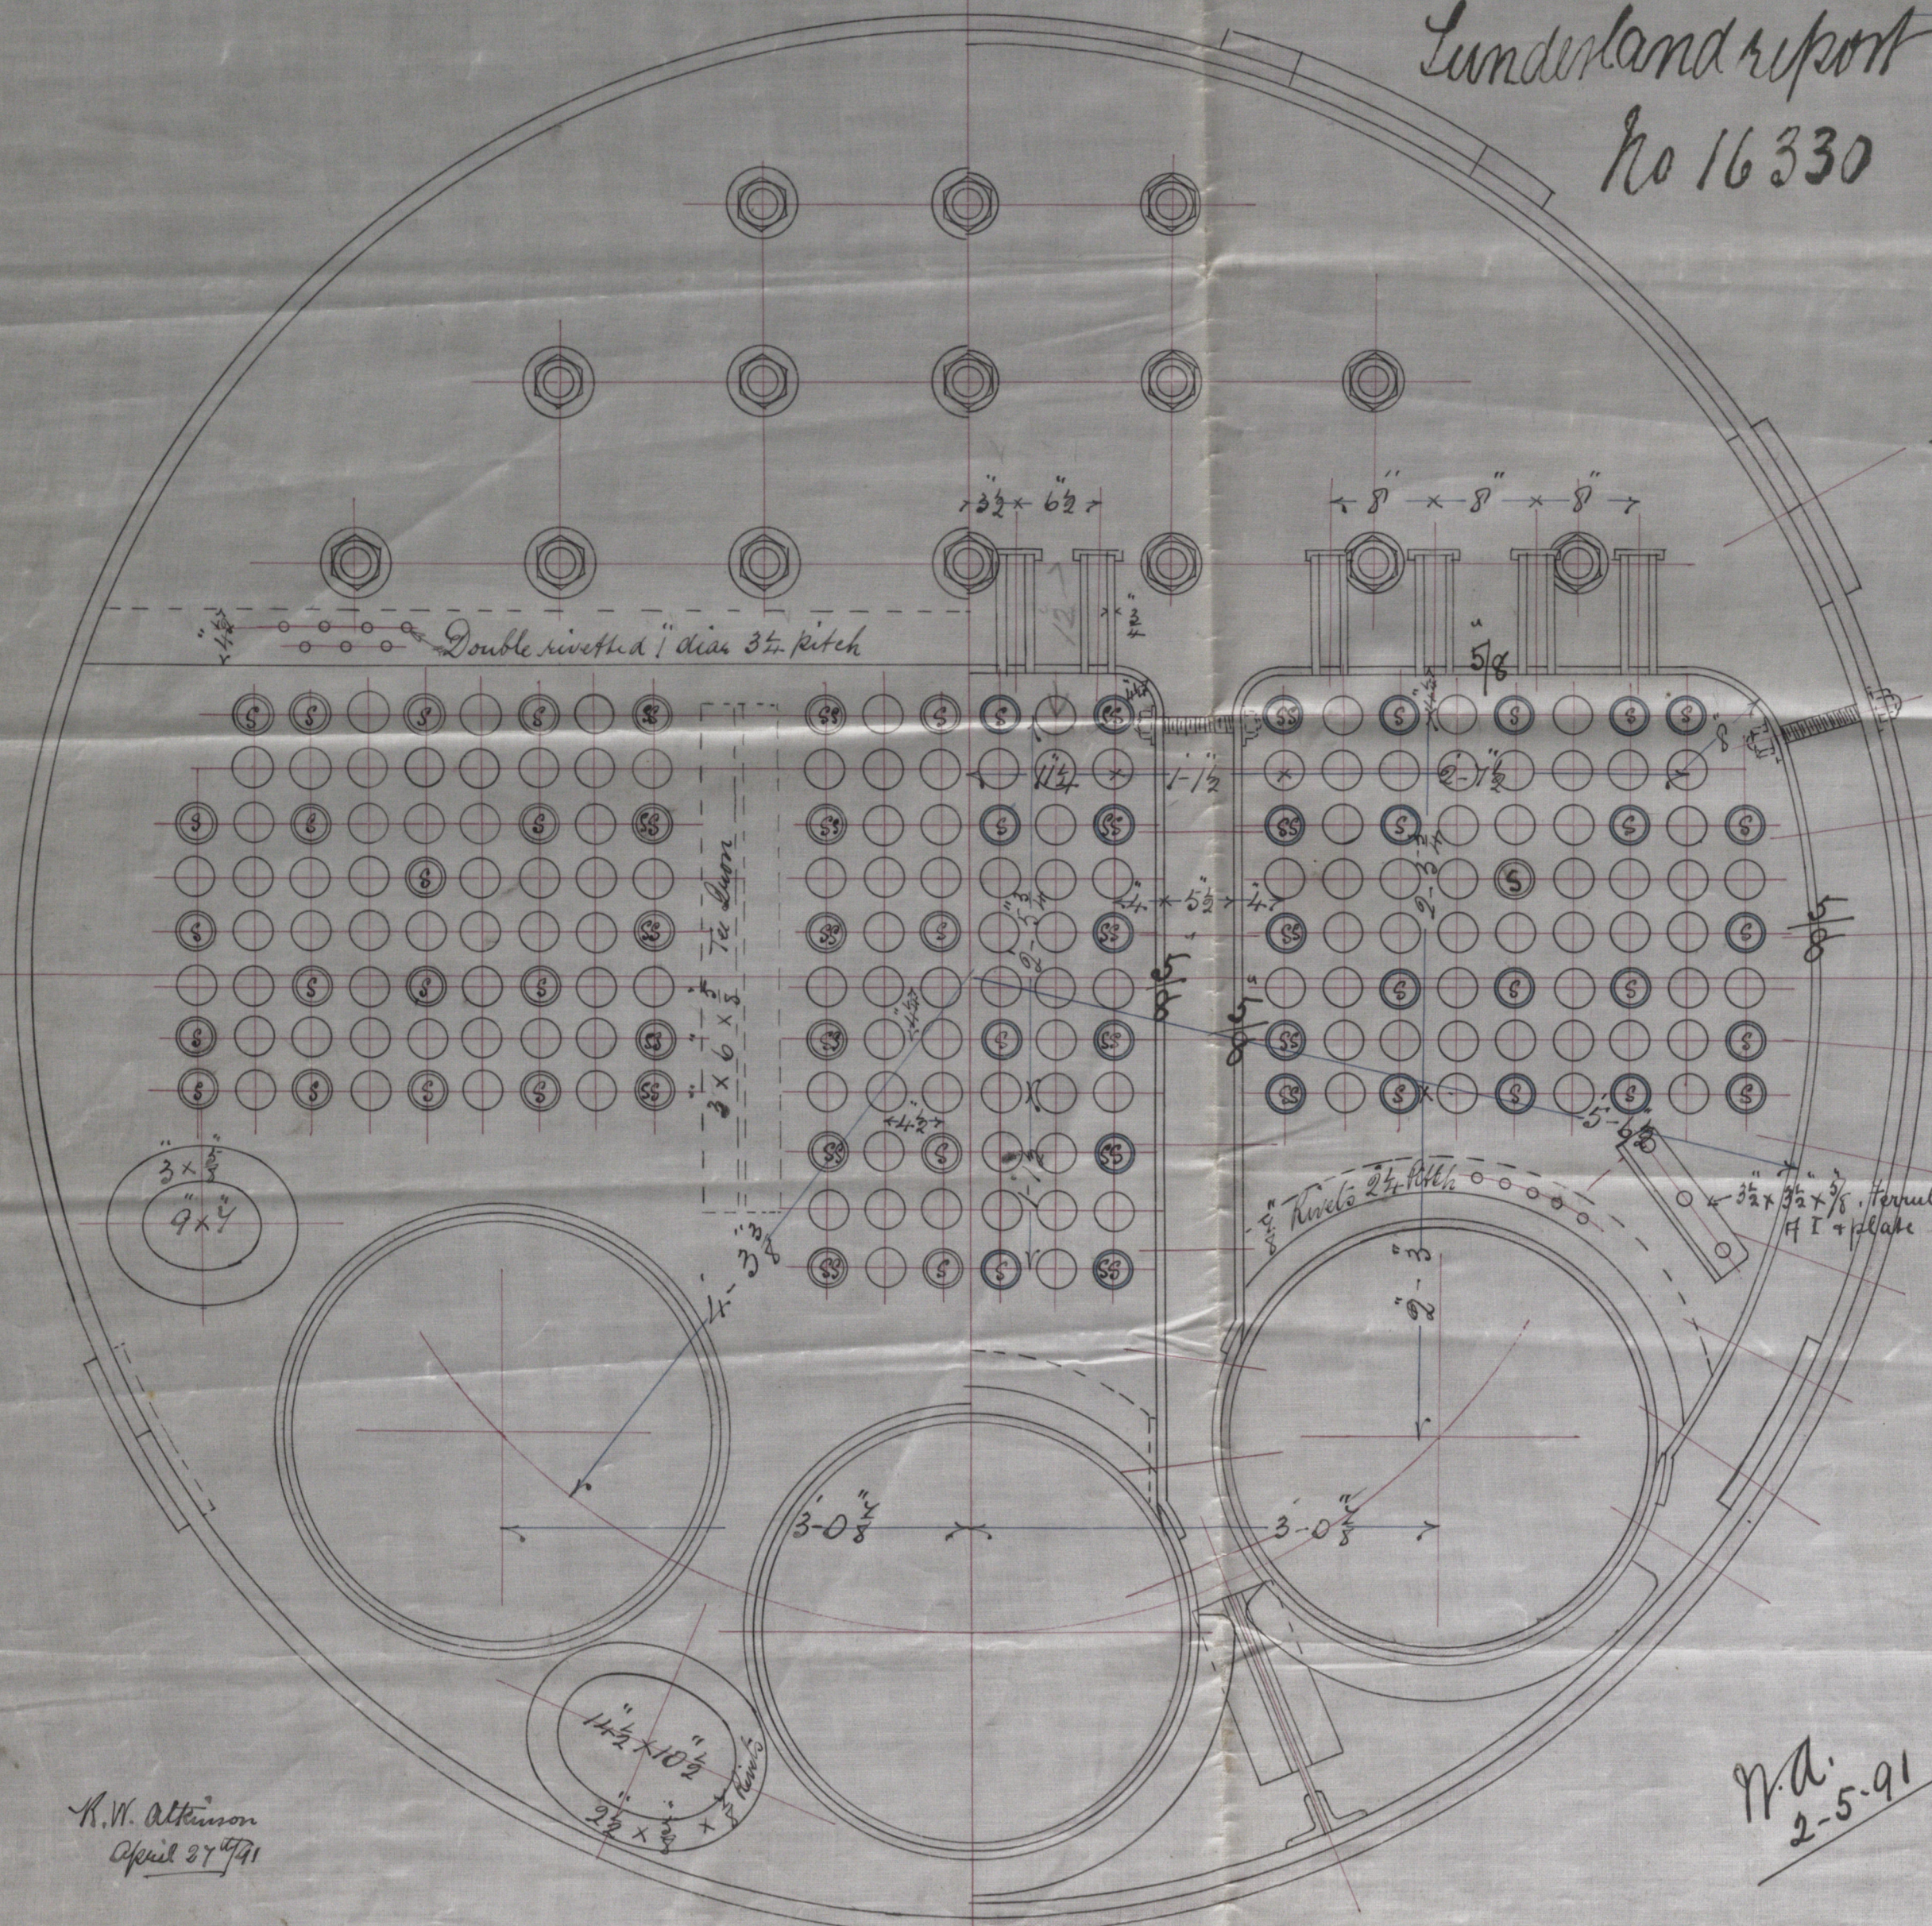


K. W. Altman
April 27/91

CONTRACT No 129.
No OFF. 2

N.A.
2-5-91

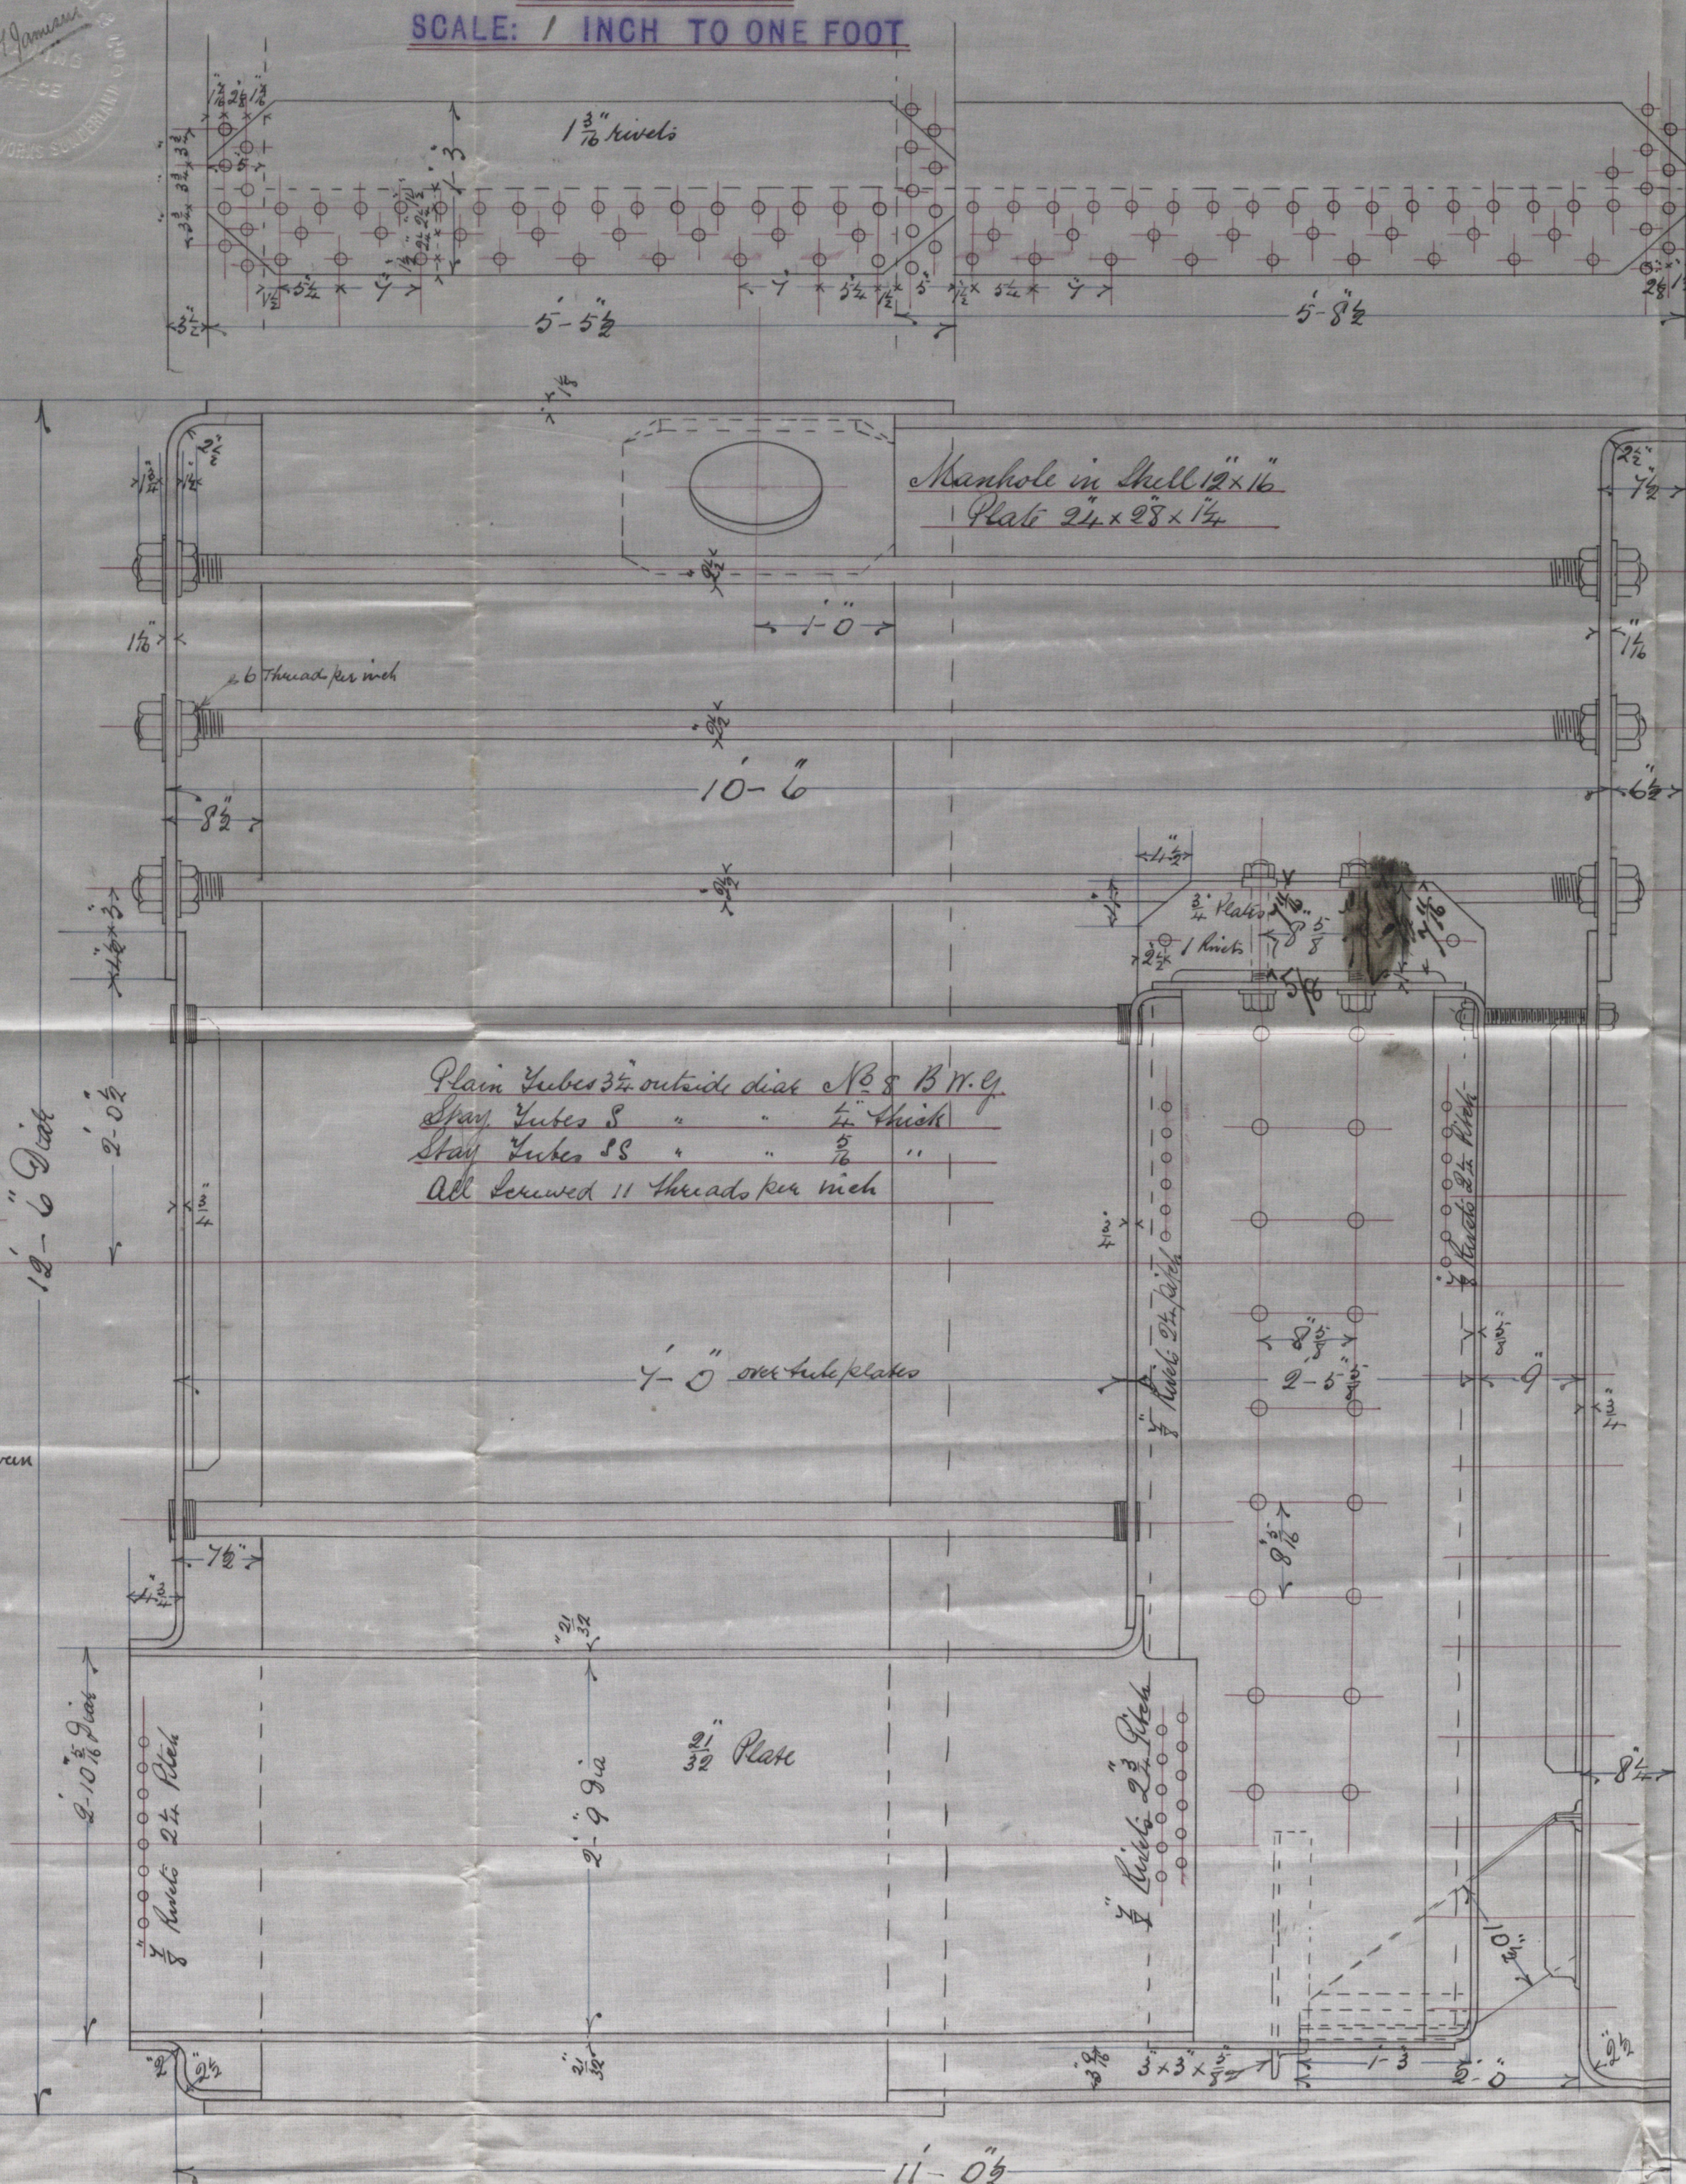

Plain Tubes 3 1/2" outside diam 18 5 B.V.G.
Spiral Tubes 8 " " 1/2" thick
Steel Tubes 8 8 " " 1/2" "
All screwed 11 threads per inch

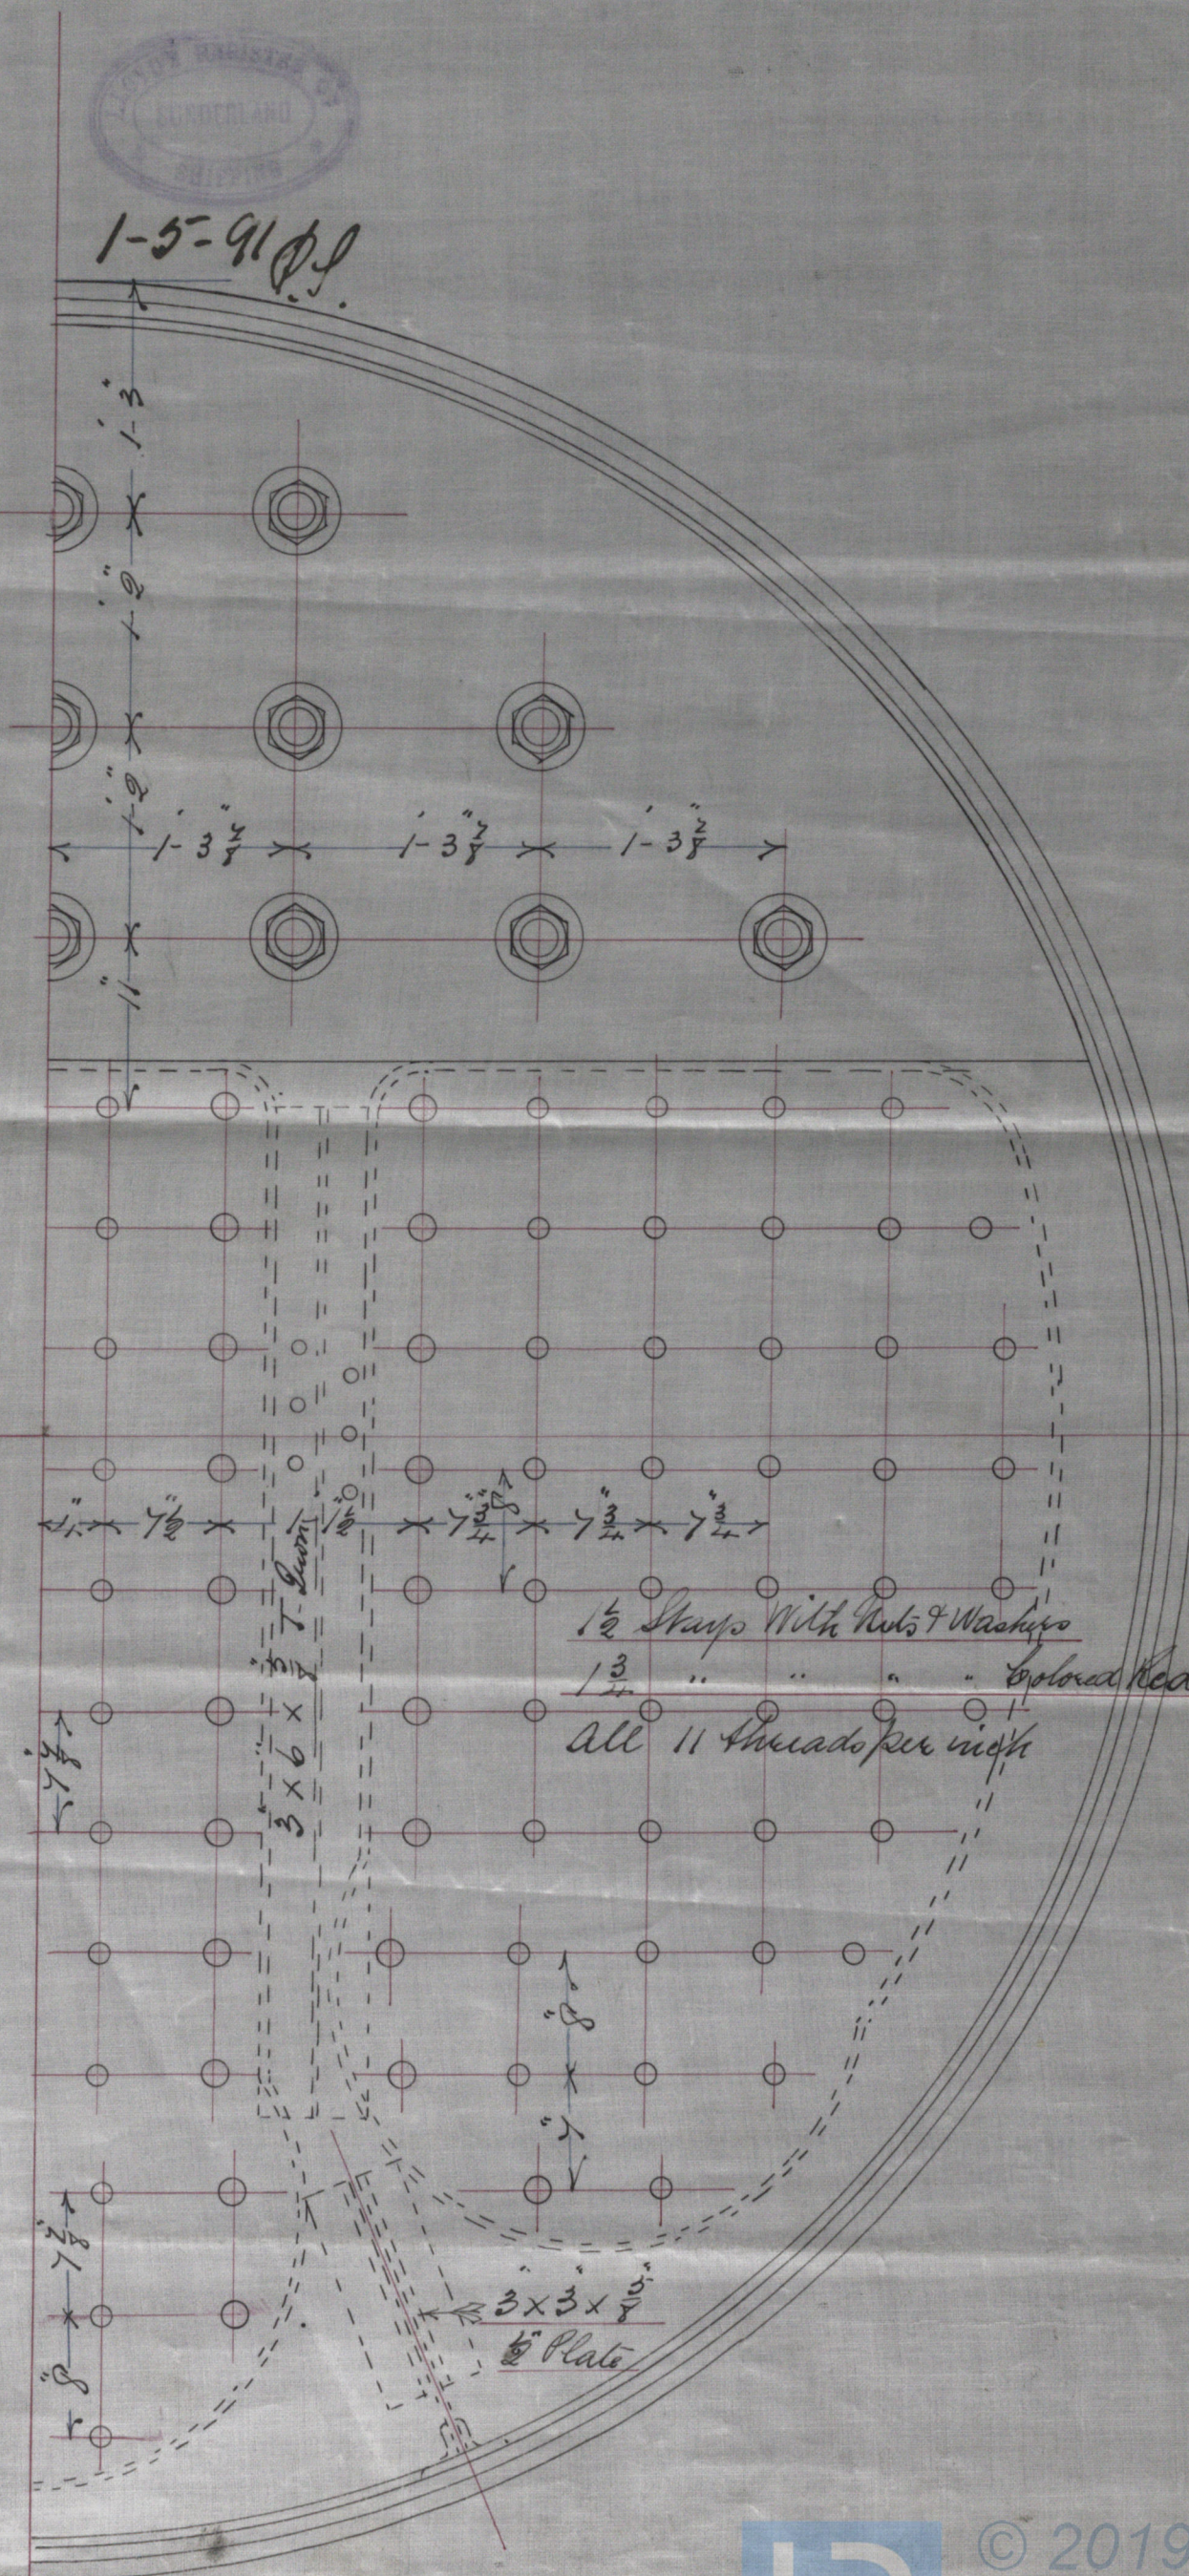

1-5-91 J.J.

HPL 366-0123



© 2019

Lloyd's Register
Foundation

S. L. Marietta Ralli
Lundon and report

No 16 330 SPL 866

HPL-366-0123

© 2019

Lloyd's Register
Foundation