


14.9.91

# N: 430 S.S. PUMPING ARRANGEMENT.


SCALE 1/8 INCH = 1 FOOT

Engine No. 120.

Central Marine Engines  
Engine & Boiler Space.

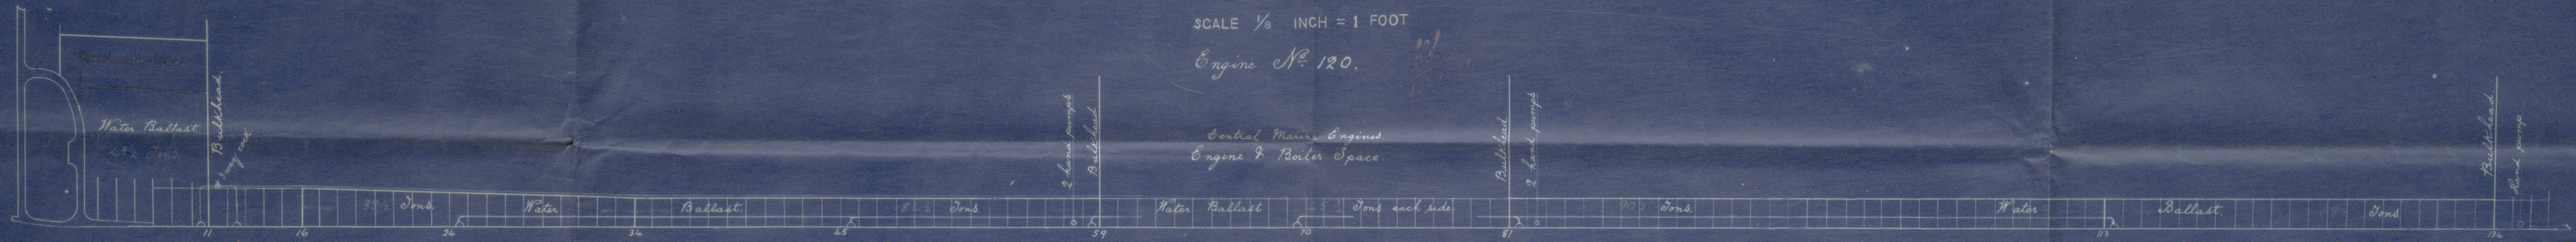

All Sluices & hand pumps worked from Deck.

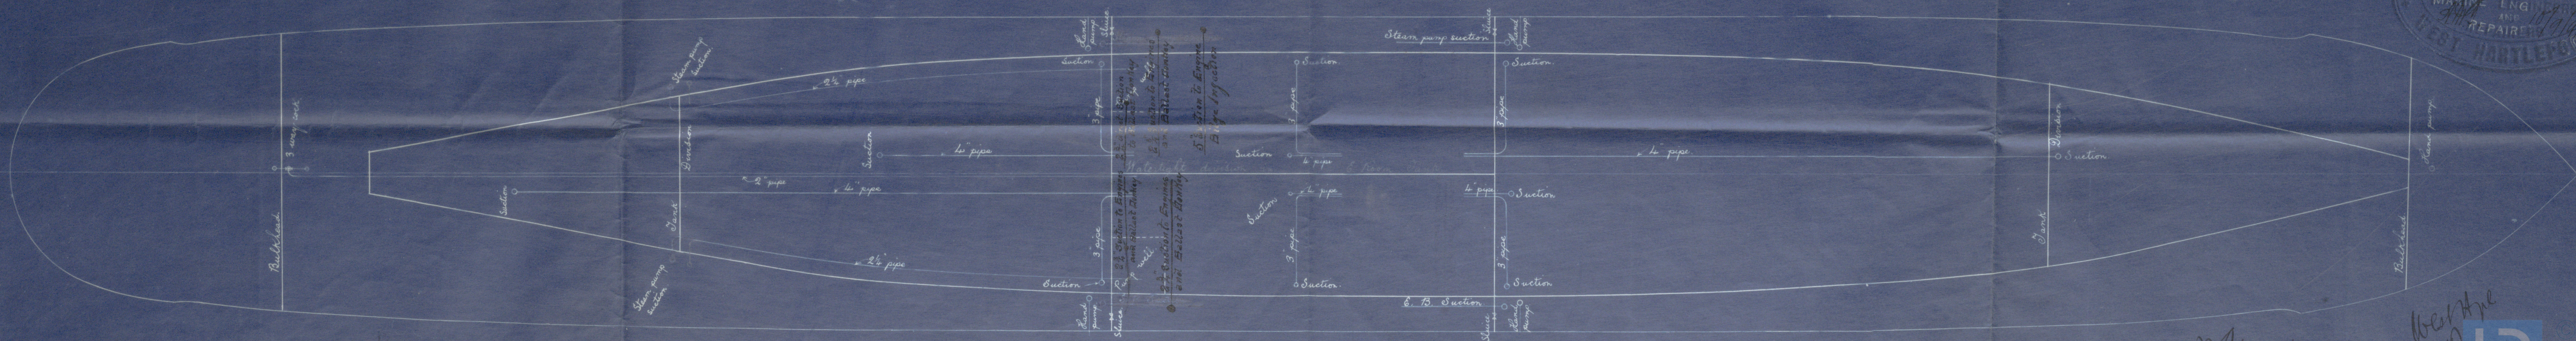

430

14.9.91

West Hartlepool



Dumping Plan.  
Messrs. W. Gray & Co. 430 nosd.

J. S. Spheroid.  
W. H. Pl. Report No. 8682.

JPL 366-0157



© 2019

Lloyd's Register  
Foundation