

J. J. Wominton

Received at

WEST HARTLEPOOL.

Office, 27th Oct 1891

Lloyd's Register of British and Foreign Shipping.

(Report on Vessel No. *8686*)

Port WEST HARTLEPOOL.)

*W. pool*No. *2034 a*

SHIP FORGINGS OR CASTINGS.

I have to report that the undermentioned Iron or Steel Forgings or Castings, manufactured by

*The Stockton Forge Co.*of *Stockton*for the Vessel No. *188*, being built by *Harper & Brithy Co.*of *Hartlepool*

have been inspected by me as set forth below, and found

to be, so far as can be seen, *sound*.

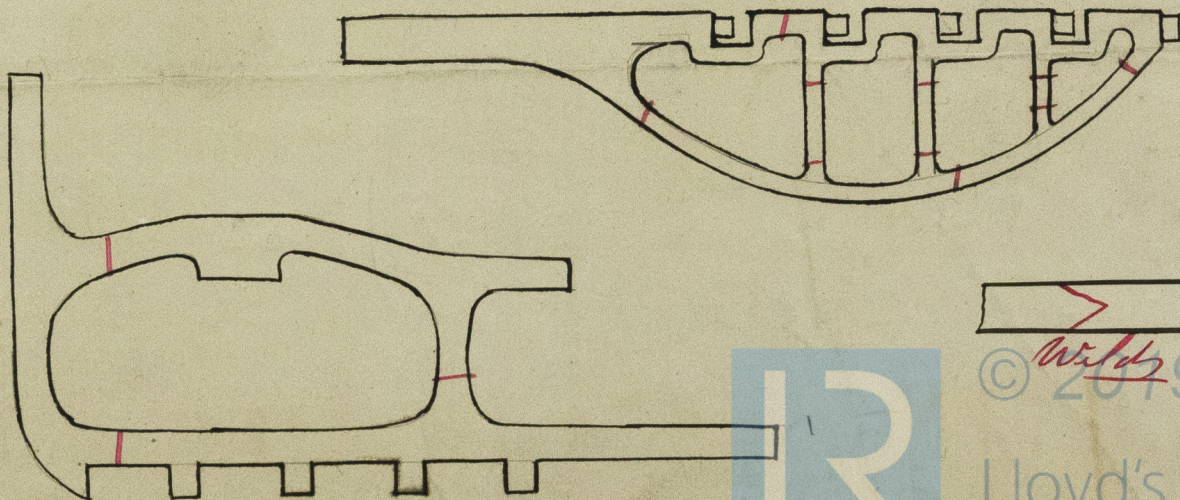
Mark on Forgings.

Lloyd's

No. *2034 a**No. 6.**W. J. Cannon**Sunderland**26. 10. 91*

	STERN FRAME.	RUDDER FRAME.	STEM.
Material* - - - -	<i>Scrap iron</i>	<i>Scrap iron</i>	<i>Scrap iron</i>
How made - - - -	<i>Forged</i>	<i>Forged</i>	<i>Forged</i>
Dimensions - - - -	<i>10" x 6"</i>	<i>7 3/4" x 3 3/4"</i>	<i>10" x 2 5/8"</i>
Progress on Inspection -	<i>Forged & smithed</i>	<i>Forged & smithed</i>	<i>Forged</i>
Dates when Inspected	<i>July 3-29/91</i>	<i>Sept 7 Oct 12/91</i>	<i>July 23/91</i>

SKETCHES OF FRAMES SHEWING POSITION AND DESCRIPTION OF WELDS OF FORGINGS, OR PARTICULARS OF TESTS APPLIED TO CASTINGS.

© *W. J. Cannon* 2019Lloyd's Register
Foundation

* If of Iron, state whether scrap or puddled Iron.