


Furness. Mithy & Co L<sup>td</sup>  
10188 St.

Sketch of Erection  
on Partial Awning  
Deck

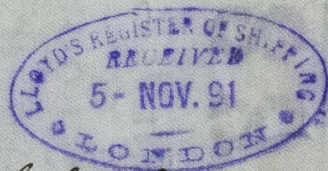

S.S. 'Honiton',  
W. H. P. Report N<sup>o</sup> 8686.

Lloyd's Register  
Foundation

HPL 366 - 0166




5.11.91.


# CASING ON BRIDGE DECK

SCALE  $\frac{1}{4}$  = ONE FOOT

*This part flaked away.*

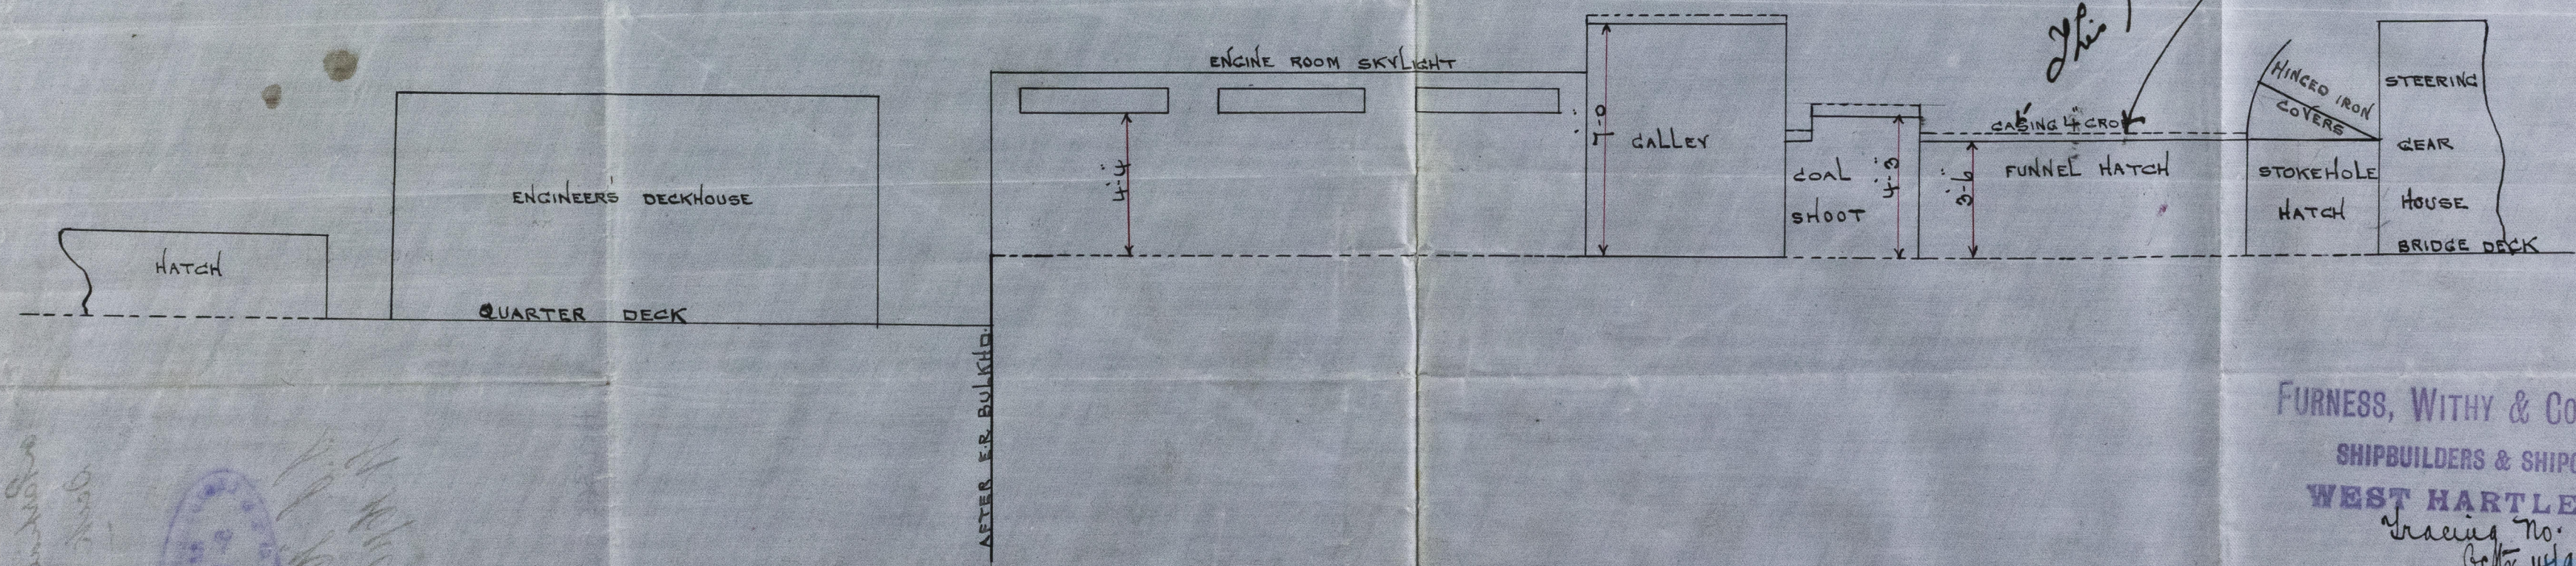

*Handwritten notes in the bottom left corner, mostly illegible.*

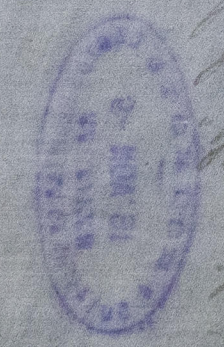

FURNESS, WITHEY & Co., LIMITED.  
SHIPBUILDERS & SHIPOWNERS,  
WEST HARTLEPOOL.

Tracing No.  
Oct 14/91

Nº 188

HPL 366-0166

*West Hpl.*  
*3/1/91*  
Lloyd's Register  
Foundation