

HPL 366 - 0167

Furness, Withy & Co.
Ld. 10.188 L.F.

Pumping
Plan

S.S. Honiton,
W. Hpl. Report No. 8656



FORE TANK

BRIDGE

HAND PUMP

AFTER TANK

HAND PUMP

AIR PIPE TO
AFTER TANK

SOUNDING PIPE

M.T. BULKHEAD
TANK DIVISION

AFTER TANK

W. Hpl. Report
No. 8656

N-1888




© 2019
Lloyd's Register
Foundation

HPL 366 - 0167

12/11/91.

PUMPING ARRANGEMENT

SCALE $\frac{1}{8}$ = 1 FOOT

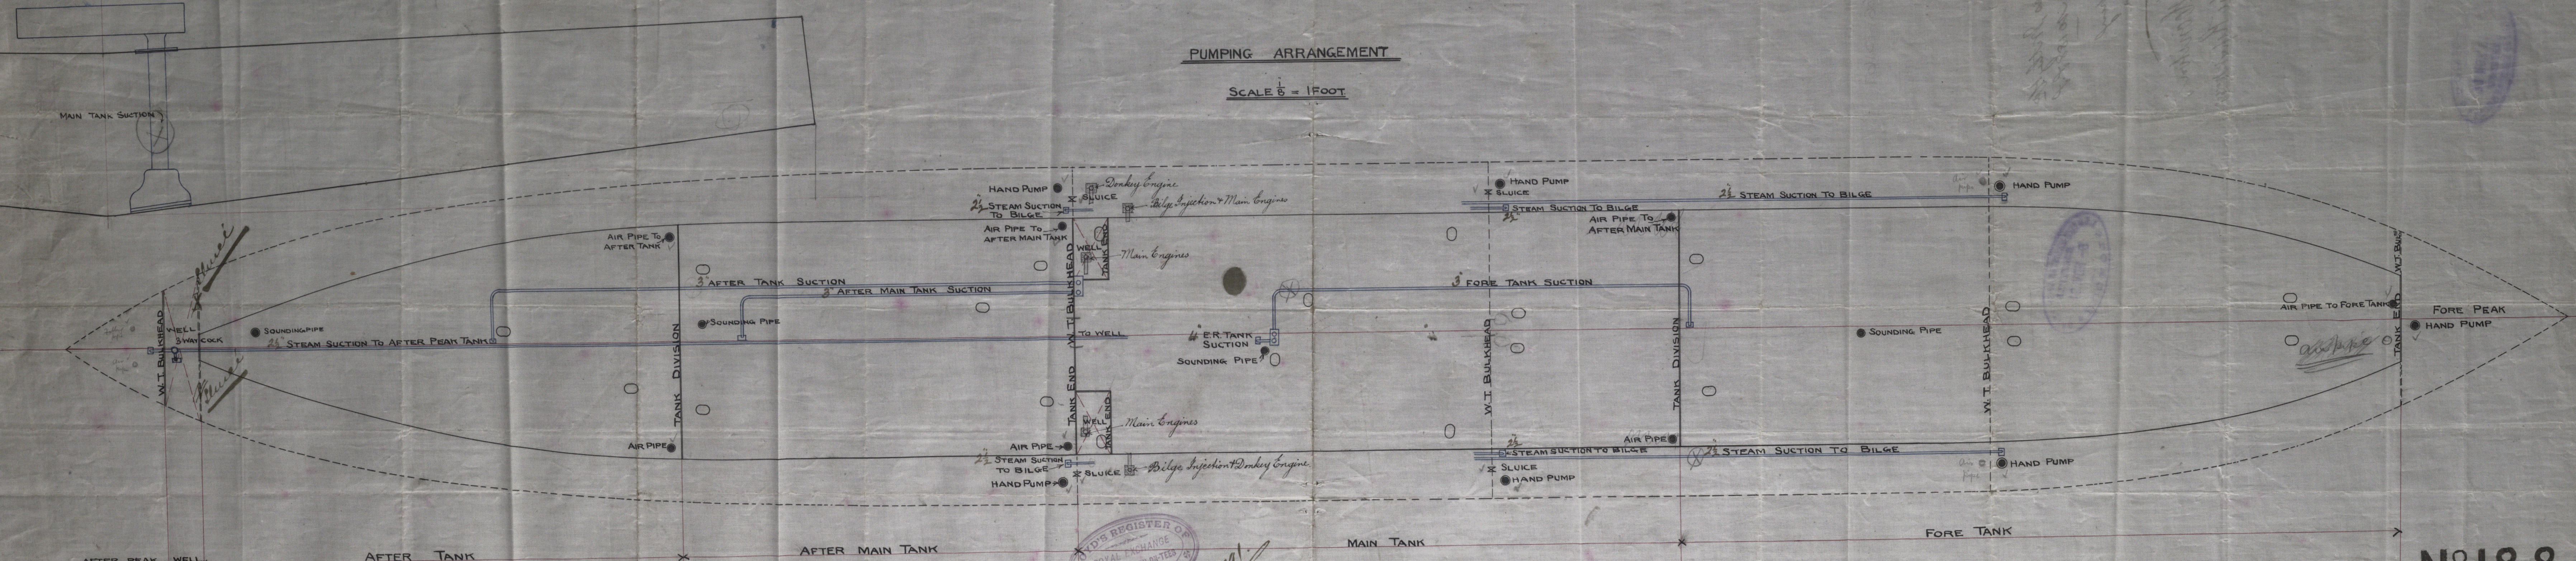

With 4 to Nov 1891

FURNESS, WITBY & CO., LD.,
SHIPBUILDERS & SHIPOWNERS,
WEST HARTLEPOOL.
TRACING NO 10157
OCTOBER 5TH 1891.

*West Hartlepool
2 Nov 91*

N^o 188

N^o 188

