

S. S. Moncton,
St. Hpl. Report No. 8686



© 2019

Lloyd's Register
Foundation

HPL366-0168

4.6.91


Revised plan 7/20

*Temporary hold down
straps*

*Painting arrangements to be made
to comply with surveyor's instructions*

JWH 14/11/91

S.S. 188.

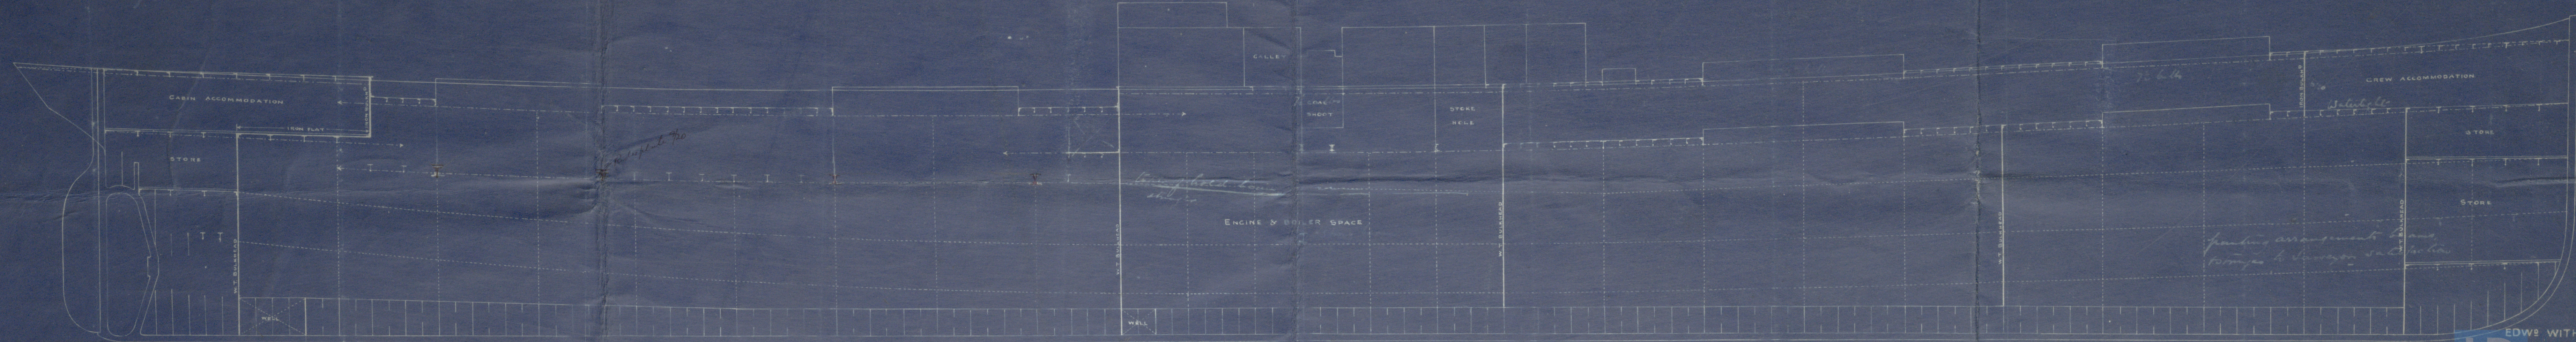

EDWARD WITHY & Co
IRON & STEEL SHIP BUILDERS
SHIP REPAIRERS &
WEST HARTLEPOOL
2nd JUNE 1891.



