

S. S. Norton

WEST HARTLEPOOL. Office *21st October 1891*
Received at

Lloyd's Register of British and Foreign Shipping.

(Report on Vessel No. *8696* Port *WEST HARTLEPOOL*.)

No. *850*

SHIP FORGINGS OR CASTINGS.

The words FORGINGS or CASTINGS, IRON or STEEL, should be struck out as may be required.

I have to report that the undermentioned Iron or ~~Steel~~ Forgings or Castings, manufactured by *Messrs Hawthorn Leslie & Co* of *Hebburn* for the Vessel No. *74*, being built by *Messrs Irvine & Co* of *Hartlepool* have been inspected by me as set forth below, and found to be, so far as can be seen, *sound*


Mark on Forgings.

Lloyd's
No. *259B*
86

John C Braig
Newcastle
17/10/91

	STERN FRAME.	RUDDER FRAME.	STEM.
Material*	<i>Scrap Iron</i>	<i>Scrap Iron</i>	
How made	<i>Forged</i>	<i>Forged</i>	
Dimensions	<i>11-5</i>	<i>7³/₄-3³/₄</i>	
Progress on Inspection	<i>Forged & Annealed</i>	<i>Forged & Annealed</i>	<i>Not seen</i>
Dates when Inspected	<i>March 4-10-18-25</i>	<i>April 10-13-28</i>	
	<i>1-3 May 4-12-14/91</i>	<i>Sept 7-14-18-23</i>	<i>Oct 1-9-14/91</i>

SKETCHES OF FRAMES SHEWING POSITION AND DESCRIPTION OF WELDS OF FORGINGS, OR PARTICULARS OF TESTS APPLIED TO CASTINGS.

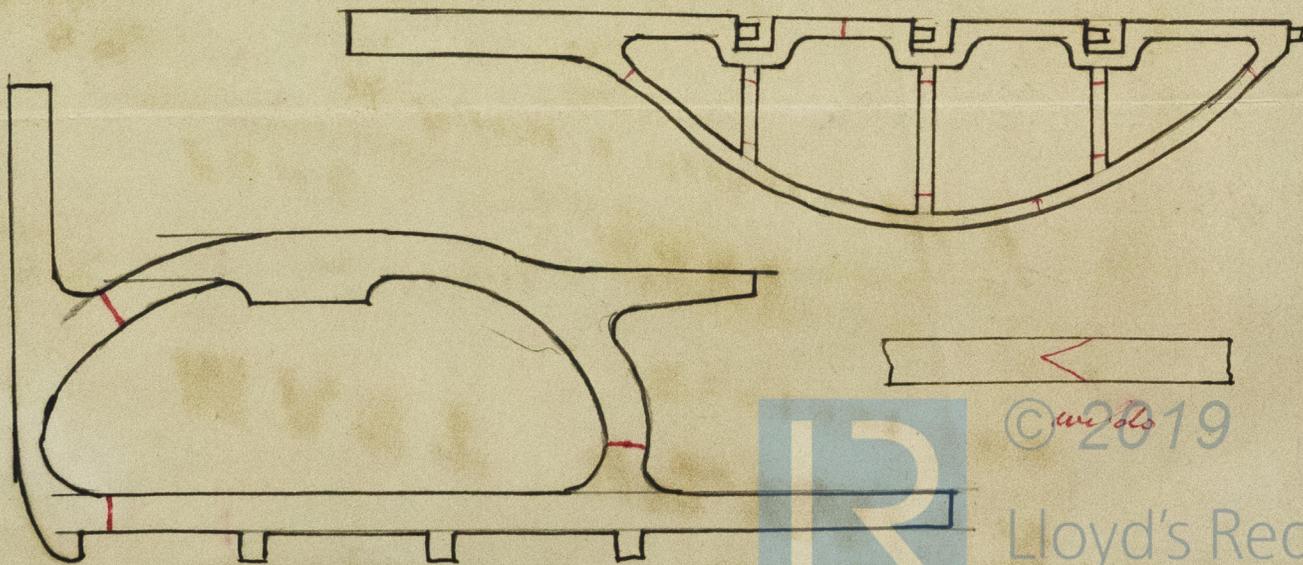

© *we do* 2019

Lloyd's Register
Foundation

259
HPL366-0177