




MON 15 SEP 90

S.S. 74

ELEVATION

SCALE 1/8" = 1 FOOT

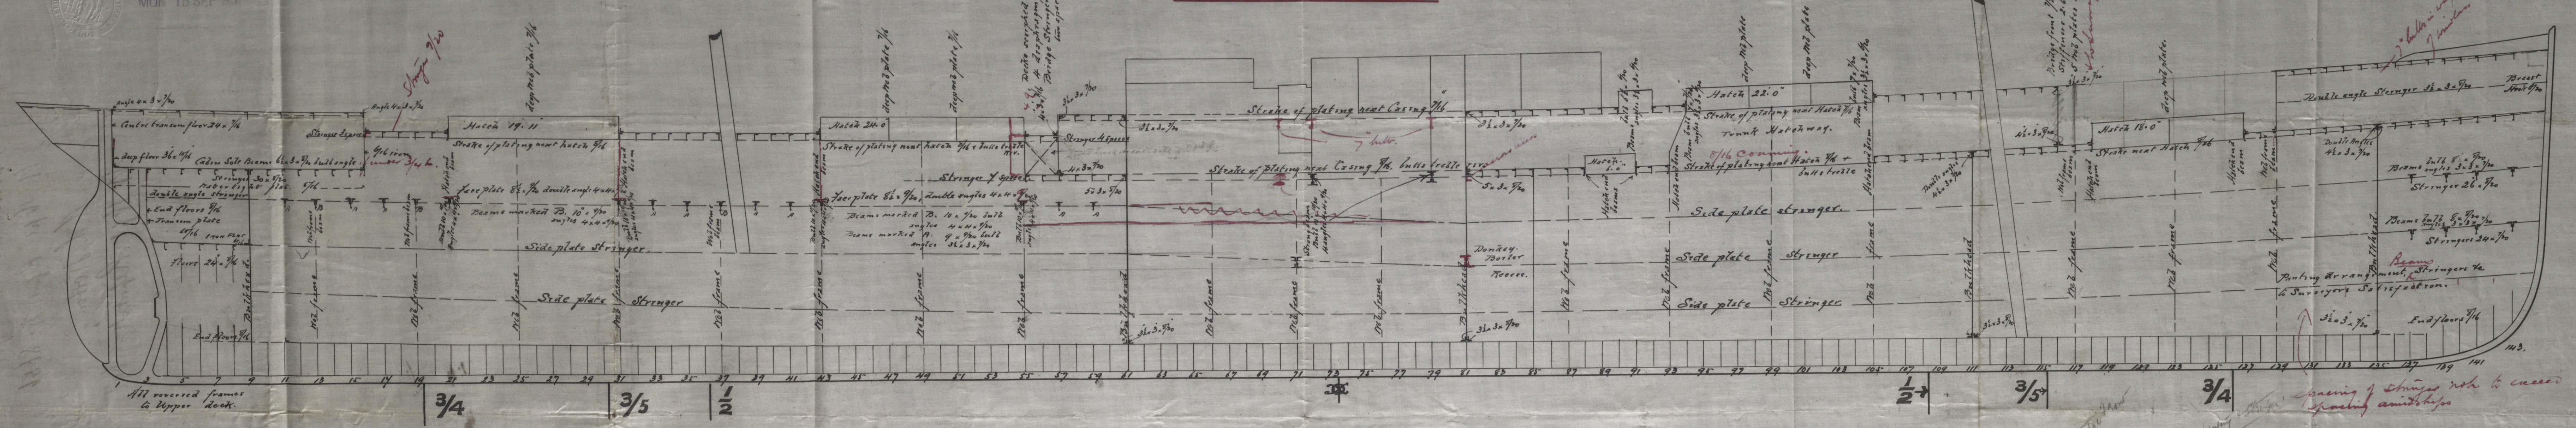

Source H^os No 74.

W. Hpl. Report No. 8656

J. S. Norton,

W. Hpl. Report No. 8696.



HPL 366-0182



© 2019

Lloyd's Register
Foundation