

J.S. 'Woodlands'

WEST HARTLEPOOL Office 11th Jan'y 18 92
Received at

Lloyd's Register of British and Foreign Shipping.

W. Wood

(Report on Vessel No. 8754 Port WEST HARTLEPOOL)
WEST HARTLEPOOL

No. 2115-a. SHIP FORGINGS OR CASTINGS.

The words FORGINGS or CASTINGS, IRON or STEEL, should be struck out as may be required.

I have to report that the undermentioned Iron or Steel Forgings or Castings, manufactured by Messrs Richardson & Sons of Warrington for the Vessel No. 189, being built by Messrs Furness Withy & Co. of Warrington have been inspected by me as set forth below, and found to be, so far as can be seen, sound.


Mark on Forgings.

Lloyd's
No. 2115-a
No. 6

W. Wood
Sunderland
9. 1. 92

	STERN FRAME.	RUDDER FRAME.	STEM.
Material*	Scrap iron	Scrap iron	Scrap iron
How made	Forged	Forged	Forged
Dimensions	10 x 6"	8" x 4"	10 x 2 3/4"
Progress on Inspection	Forged & smithed	Forged & smithed	Forged
Dates when Inspected	Sept 8 - 25/91	Nov 5 - Dec 24/91	Oct 8/91

SKETCHES OF FRAMES SHEWING POSITION AND DESCRIPTION OF WELDS OF FORGINGS, OR PARTICULARS OF TESTS APPLIED TO CASTINGS.

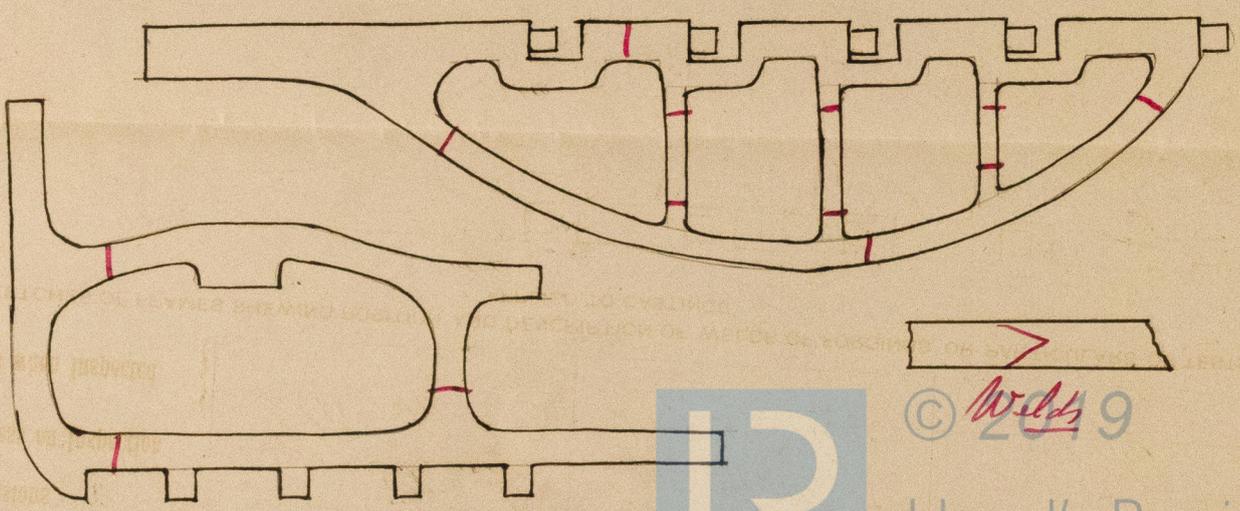

Welds
© 2019

* If of Iron, state whether scrap or puddled Iron.