


12.11.91.

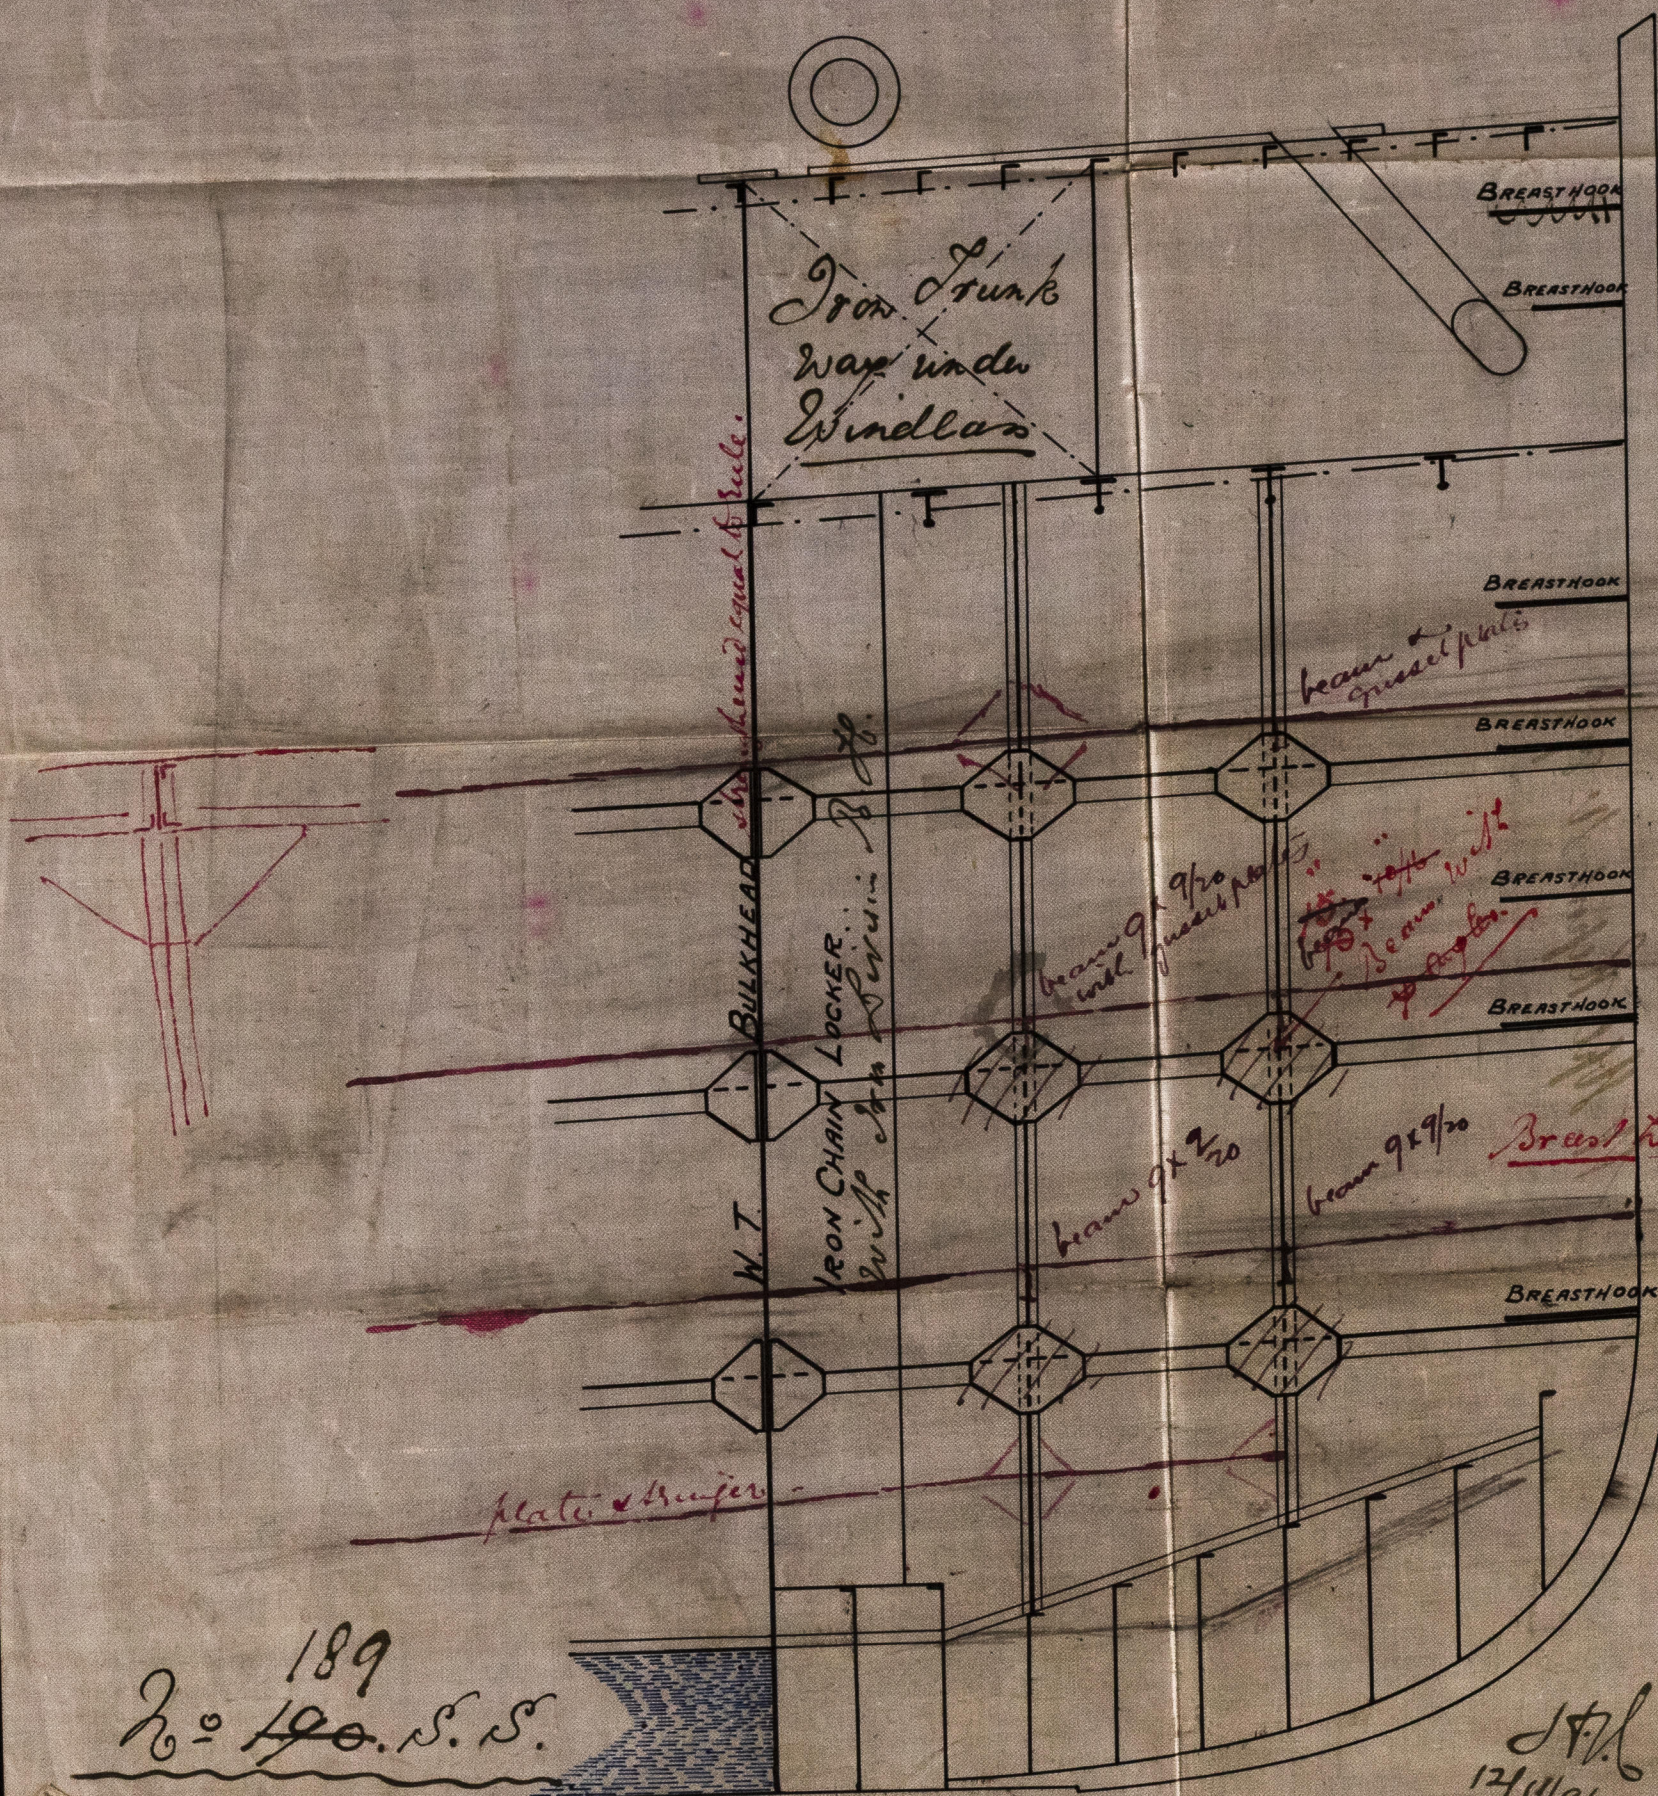

FURNESS, WITBY & CO., LD.,  
SHIPBUILDERS & SHIPOWNERS,  
WEST HARTLEPOOL.  
30th Sept 1891


© 2020  
Lloyd's Register  
Foundation

189  
No. 190. S.S.

12/11/91

Furness Mithy & Co. Ltd.  
189  
~~190~~ Vessel

Fore Peak painting  
arrangements

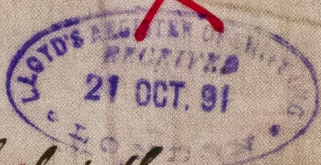

HPL 367-0043

S.S. 'Headlands',

W. Hpl. Report No. 8754

© 2020

Lloyd's Register  
Foundation