


4.9.91.

PROFILE

SCALE  $\frac{1}{8}$  = 1 FOOT

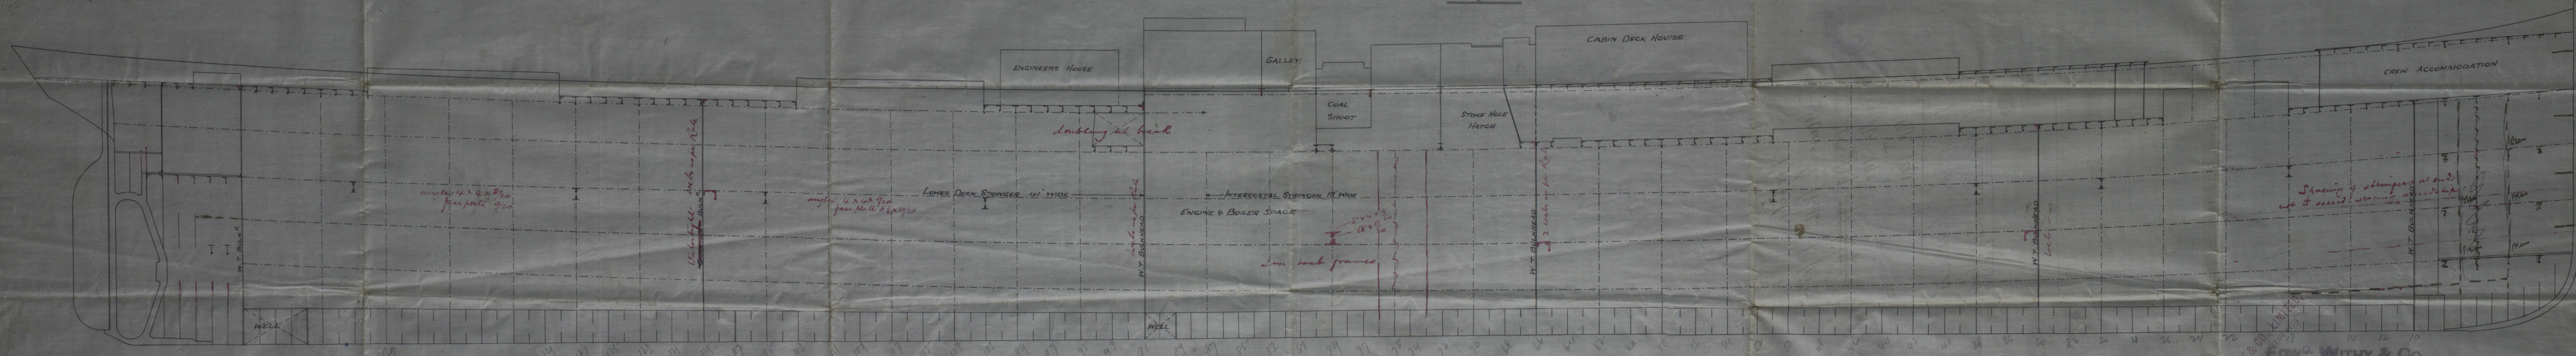

NOS 189 & 90 91 & 92.  
 & 190 & 191: 195.  
 2.10.91.  
 30.11.91

4/9/91

EDWARD WITTHY & CO.  
 SHIP BUILDERS,  
 JULY 9TH 1891.  
 SHIP REPAIRERS &  
 TRADING NO 9973  
 WEST HARTLEPOOL.



Profile

Messrs. G. Wilby & Co's

No. 189, ~~191 & 192~~

No. 190

<sup>T</sup>  
No. 191

No. 189. - S. S. Headlands,

W. H. P. Report No. 8695  
8754

HPL367-0045

© 2020

Lloyd's Register  
Foundation