



Ltr. to Builders.
 13/11/91.


SKETCH OF BRACKET
 on all new

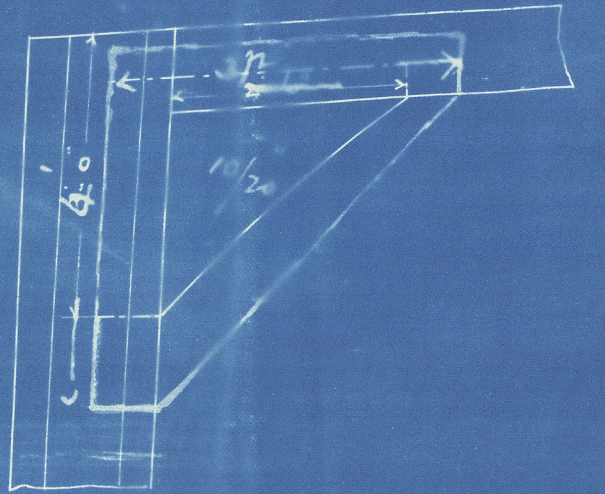

PROFILE
 SCALE $\frac{1}{8}$ = 1 FOOT

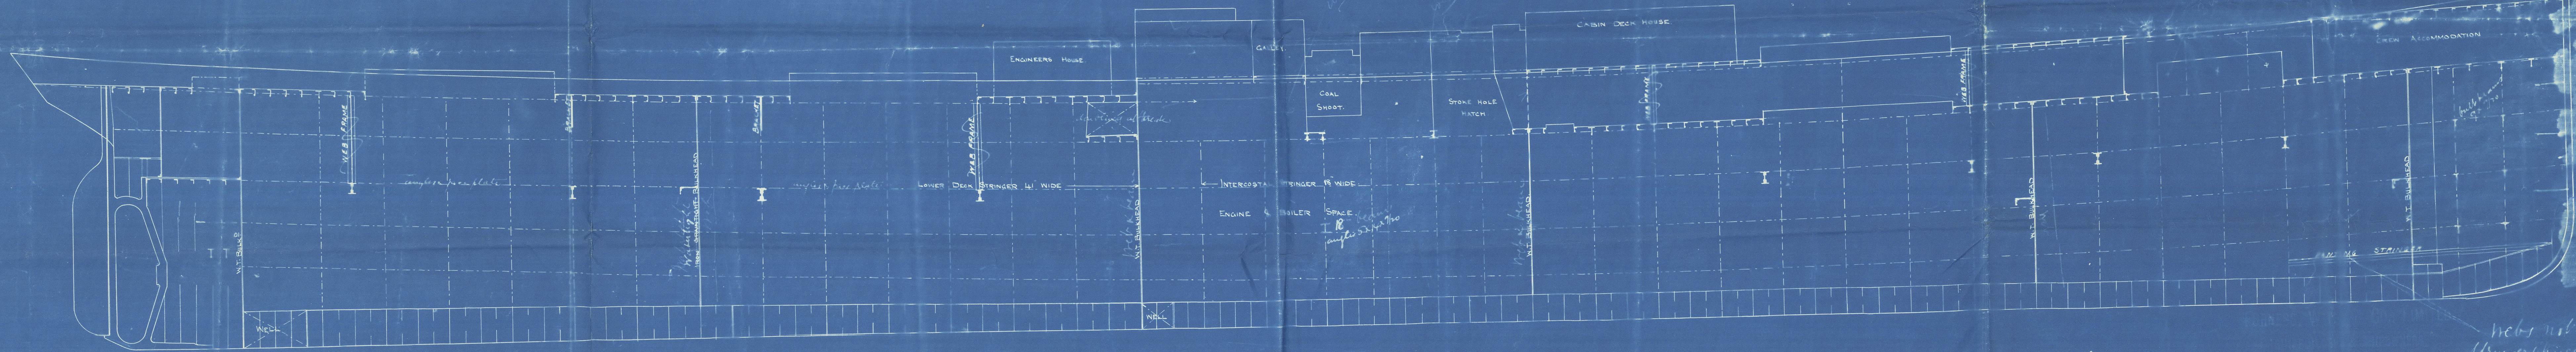

N°189

20/6
 11/11/91

webs not cut
 stringers need to be
 and fitted with diamond plates

Furness Wether & Co.

No. 189

2 P^{ts} file showing
proposed compensation
for Small Beam Knees.



S.S. 'Headlands',

W. H. Pl. Report No. 8754

HPL367-0047



© 2020

Lloyd's Register
Foundation