

S.S. "Gastray"

Received at WEST HARTLEPOOL Office.

18th Feb 1892

Lloyd's Register of British and Foreign Shipping.

(Report on Vessel No. 8761 Port WEST HARTLEPOOL.)

Wpool

No. 2134.a

SHIP FORGINGS OR CASTINGS.

I have to report that the undermentioned Iron or Steel Forgings or Castings, manufactured by

The Sunderland Forge Co. of Pallion

for the Vessel No. 190, being built by Messrs Furness Withy & Co

of Newcastle have been inspected by me as set forth below, and found to be, so far as can be seen, sound.

The words FORGINGS or CASTINGS, IRON or STEEL, should be struck out as may be required.

Mark on Forgings.


Lloyd's No. 2134.a 86.6

W. J. Cameron

Sunderland 1.2.92


	STERN FRAME.	RUDDER FRAME.	STEM.
Material*	Scrap iron	Scrap iron	Scrap iron
How made	Forged	Forged	Forged
Dimensions	10' x 6'	8' x 4'	10' x 2 3/4'
Progress on Inspection	Forged & Smithed	Forged & Smithed	Forged
Dates when Inspected	Oct 2-13-28 Nov 7-12/91	Dec 7-12-22/91 Jan 9/92	Nov 11/91

SKETCHES OF FRAMES SHEWING POSITION AND DESCRIPTION OF WELDS OF FORGINGS, OR PARTICULARS OF TESTS APPLIED TO CASTINGS.

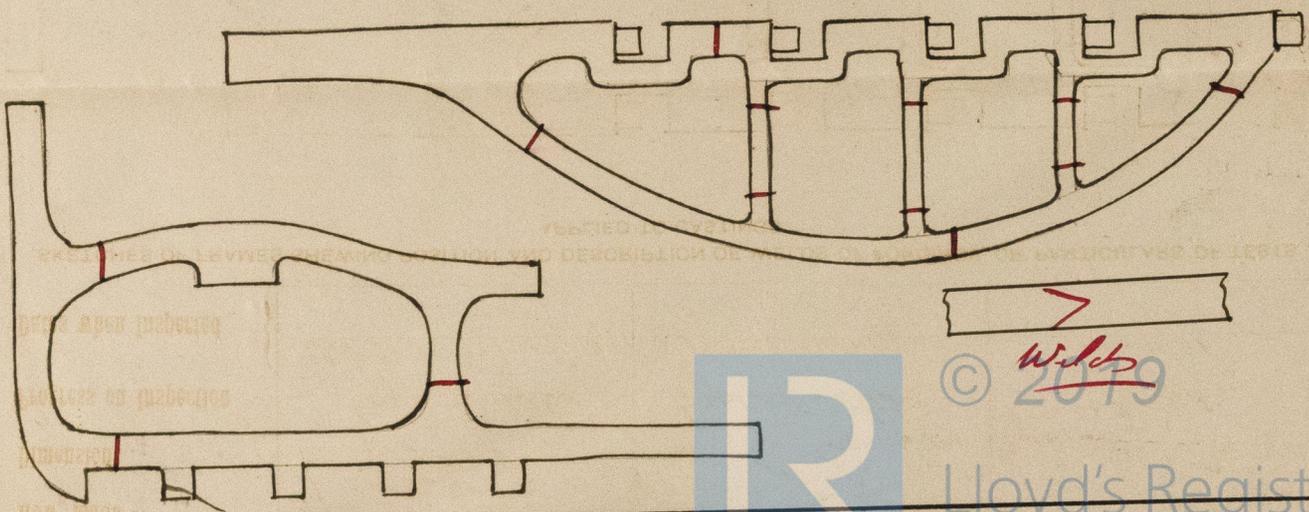

* If of Iron, state whether scrap or puddled Iron.

2134

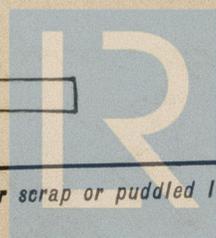

© 2019

Lloyd's Register Foundation

HPL367-0052