

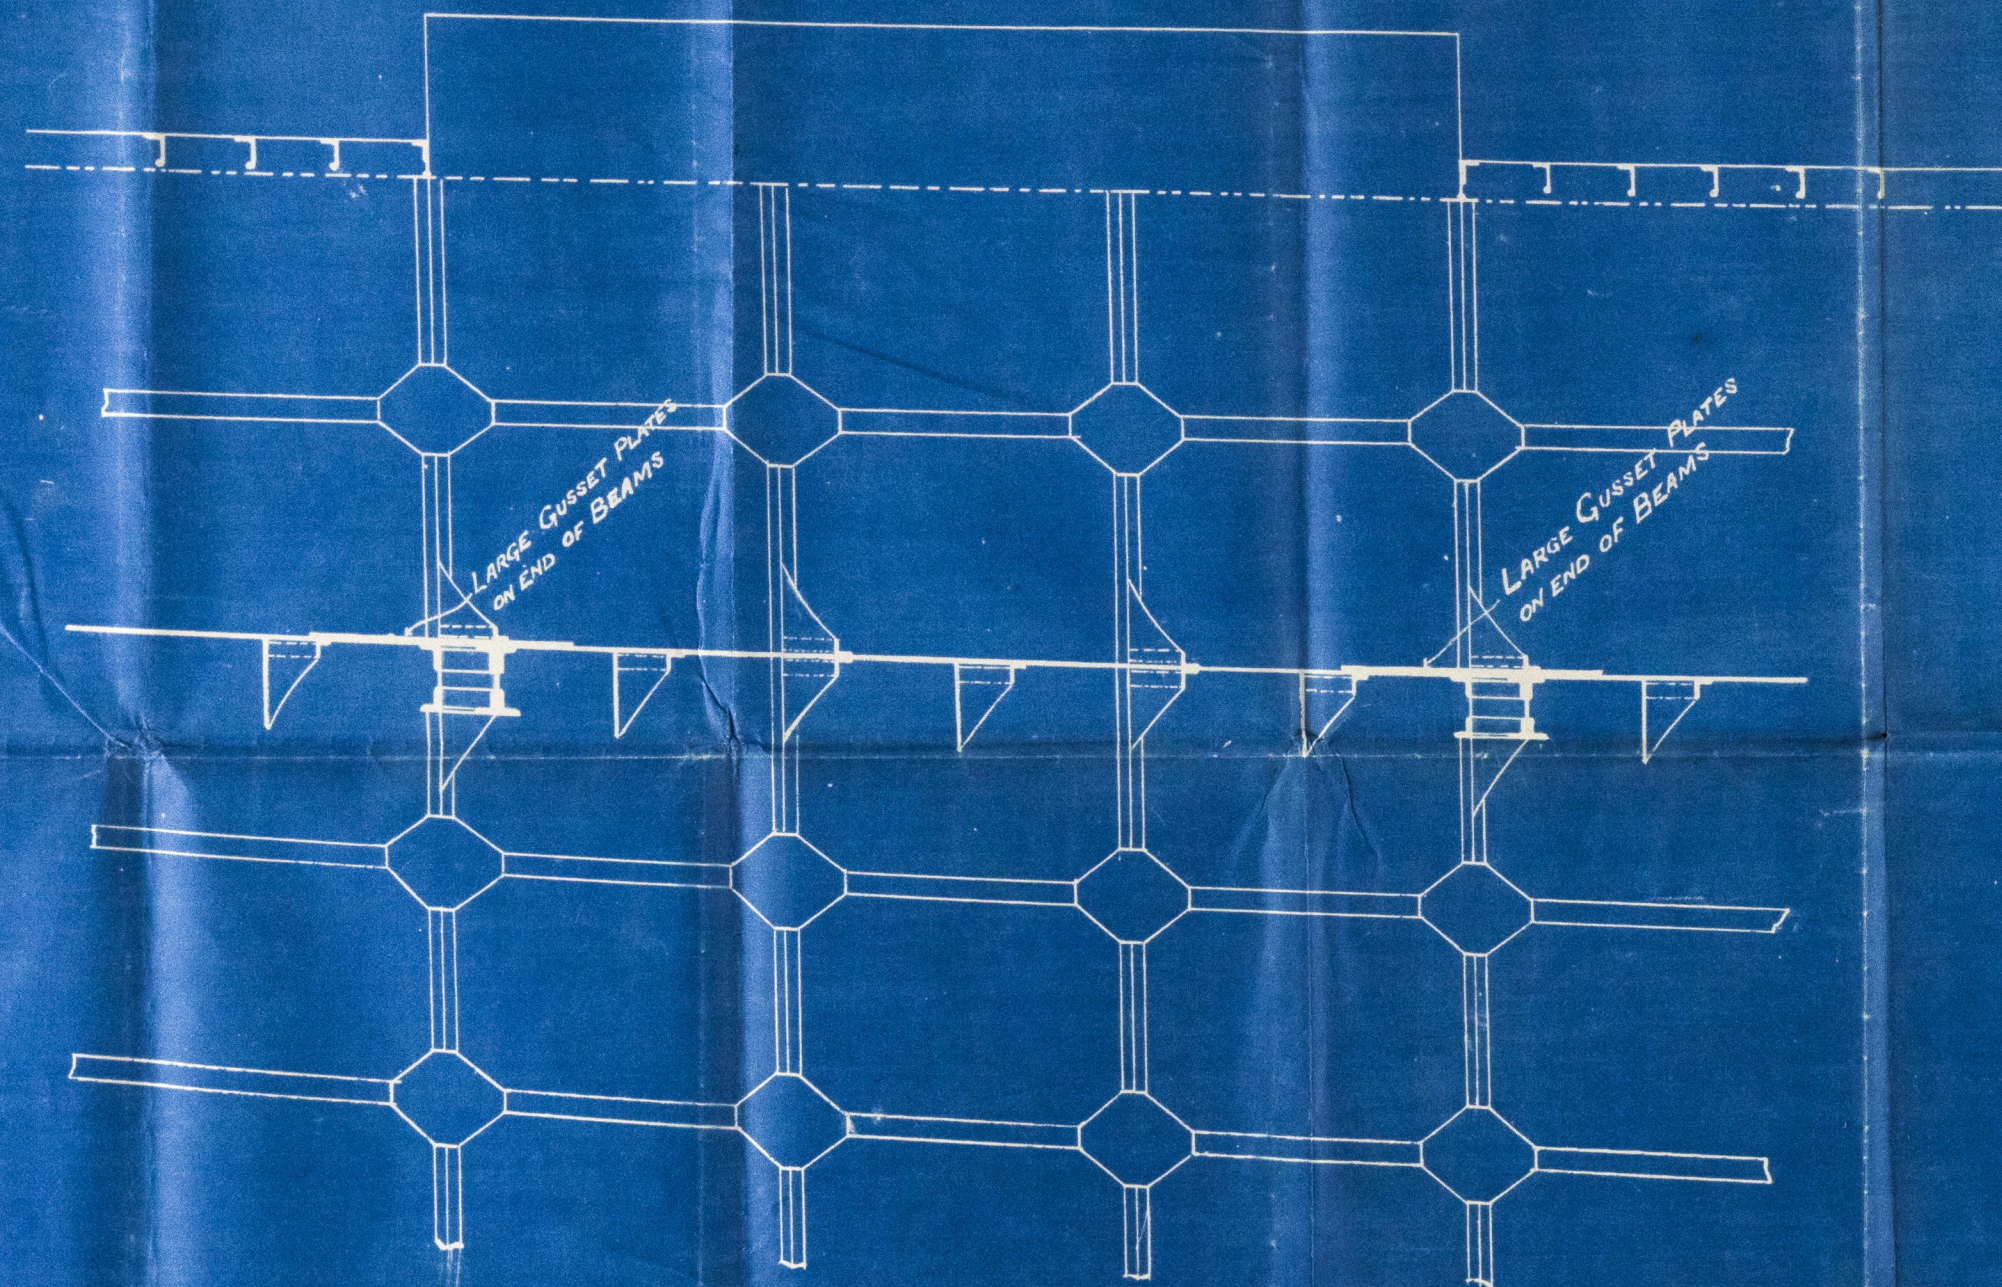


SKETCH SHEWING LOWER DECK STRINGER
SCALE $\frac{1}{4} = 1 \text{ FOOT}$

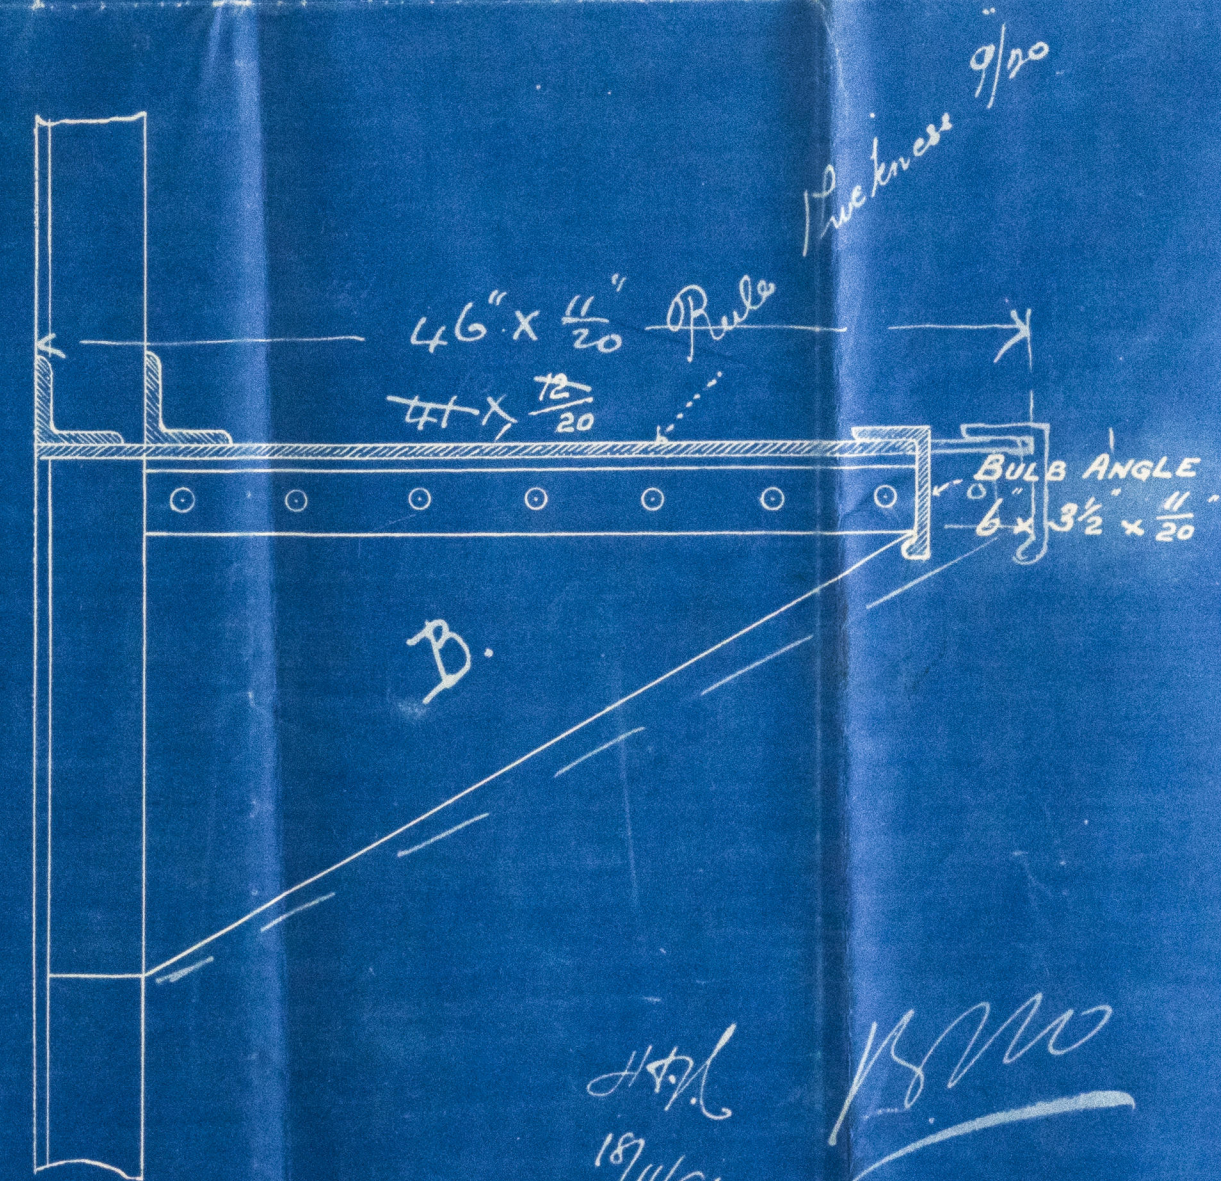

*20 = 190 and all
beside of this size.
Could not do this in 190 as the
material is all in yard*

was done in 190

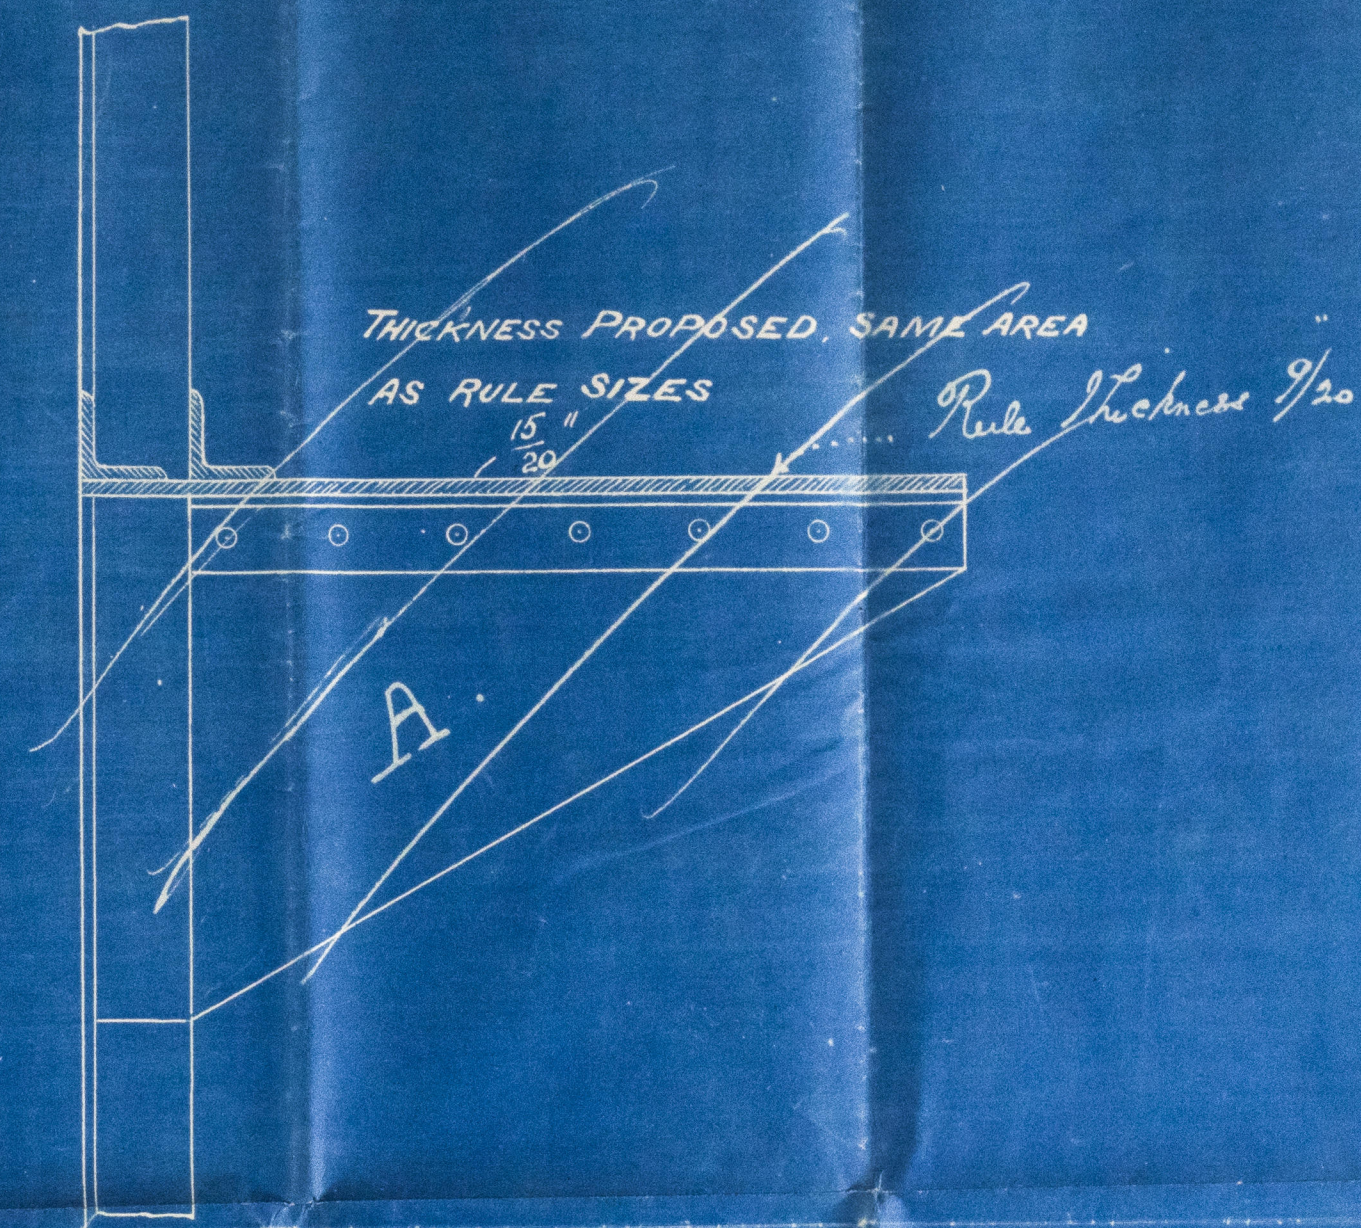

19.11.91.

H.H.L.
18/11/91

1800

Furness Writing Co.

No. 190

Lower an. Stringer in
after hold.

S. S. Gaston;

W. Hpl. Report No. 8761

HPL367-0056

© 2020

Lloyd's Register
Foundation