


S.S. EASTRY

PUMPING ARRANGEMENT

SCALE 1/8" = 1 FOOT

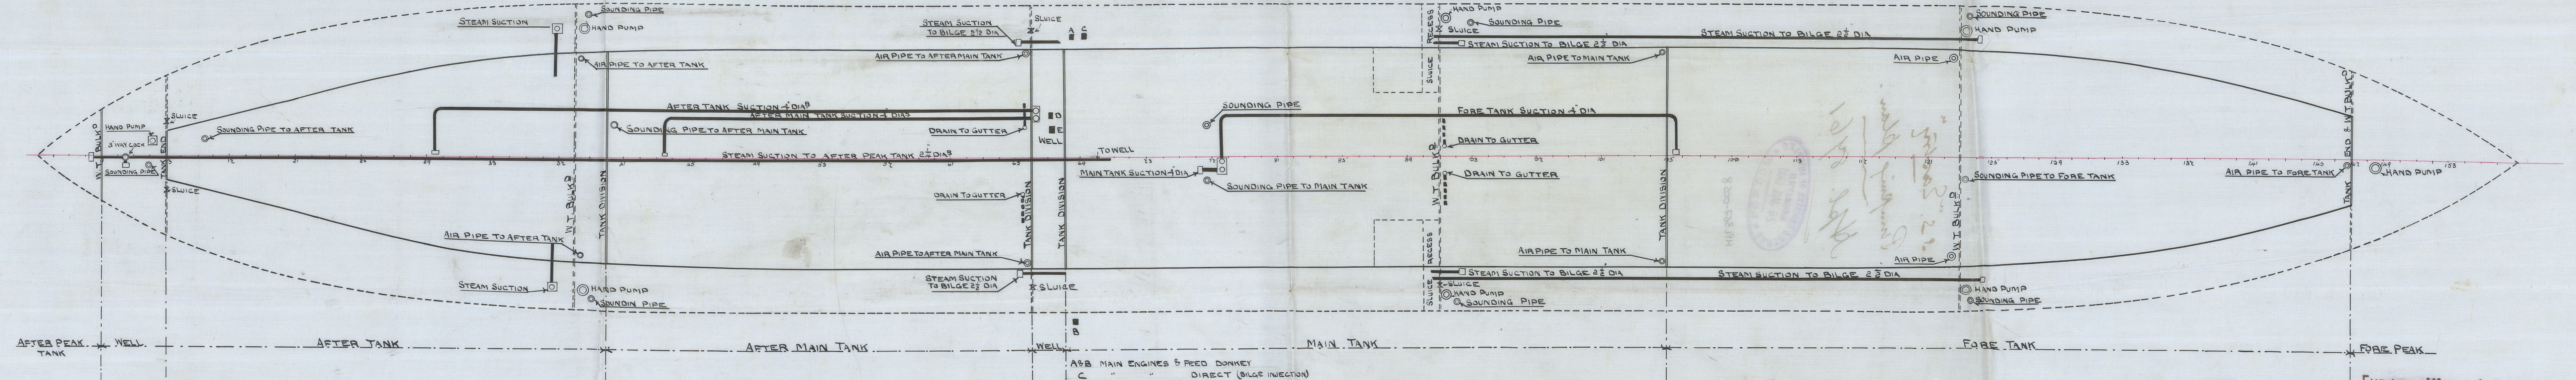

No 190

No 190

- A & B MAIN ENGINES & FEED DONKEY
- C " " DIRECT (BILGE INJECTION)
- D BALLAST DONKEY DIRECT
- E BILGE PUMPS DIRECT

FURNESS WITBY & CO. LIMITED.

SHIPBUILDERS & REPAIRERS.

WEST HARTLEPOOL.


January 24th/00

2020
N.D.'s Register
Foundation
HPL367-0058

S.S. "Easty"

Pumping plan.

Apr. 8/61

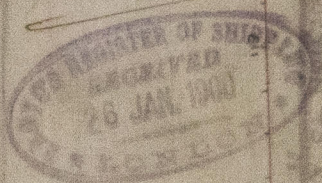

HPL367-0058



LR

© 2020

Lloyd's Register
Foundation