

(Form No. 43.) *Birdsward*

Received at **WEST HARTLEPOOL** Office, 9th March 1892

Lloyd's Register of British and Foreign Shipping.

The records FORGINGS or CASTINGS, IRON or STEEL, should be struck out as may be required.

Wpool

(Report on Vessel No. 8863 Port **WEST HARTLEPOOL**)

No. 2173.a

SHIP FORGINGS OR CASTINGS.

I have to report that the undermentioned Iron or ~~Steel~~ Forgings or Castings, manufactured by The Sunduland Forge Co. of Pallion for the Vessel No. 191, being built by Imp. Furness & Co. Ltd. of Hartlepool have been inspected by me as set forth below, and found to be, so far as can be seen, _____



Mark on Forgings.

Lloyd's
No. 2173.a
10.6

Hugh Cameron
Sunduland
8. 3. 92

	STERN FRAME.	RUDDER FRAME.	STEM.
Material*	Scrap iron	Scrap iron	Scrap iron
How made	Forged	Forged	Forged
Dimensions	10' x 6"	8' - 4"	10' x 2 3/4"
Progress on Inspection	Forged & Smithed	Forged & Smithed	Forged
Dates when Inspected	Dec 7. 23/91	Jan 13 March 2/92	Dec 17/91

SKETCHES OF FRAMES SHEWING POSITION AND DESCRIPTION OF WELDS OF FORGINGS, OR PARTICULARS OF TESTS APPLIED TO CASTINGS.

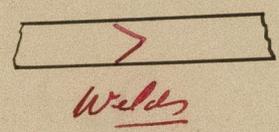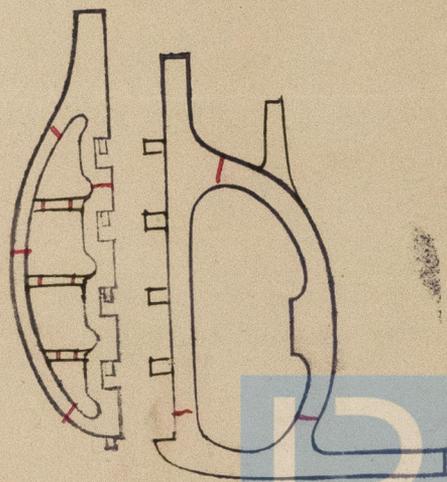

© 2019

Lloyd's Register Foundation

* If of Iron, state whether scrap or puddled Iron.