

*J. J. Craffoe*

Received at WEST HARTLEPOOL on 11<sup>th</sup> May 1892

# Lloyd's Register of British and Foreign Shipping.

Wpool

(Report on Vessel No. 8895 Port WEST HARTLEPOOL.)

No. 2196 a

## SHIP FORGINGS OR CASTINGS.

The words FORGINGS or CASTINGS, IRON or STEEL, should be struck out as may be required.

I have to report that the undermentioned Iron or ~~Steel~~ Forgings or Castings, manufactured by Messrs J. Richardson Sons of Warrington for the Vessel No. 195, being built by Messrs Furness Withy & Co. of Warrington have been inspected by me as set forth below, and found to be, so far as can be seen, sound.

Mark on Forgings.


Lloyd's  
No. 2196 a  
10-6

*W. J. Cannon*  
Sunderland.

10-5-92

	STERN FRAME.	RUDDER FRAME.	STEM.
Material*	<u>Scrap iron</u>	<u>Scrap iron</u>	<u>Scrap iron</u>
How made	<u>Forged</u>	<u>Forged</u>	<u>Forged</u>
Dimensions	<u>10" x 6"</u>	<u>8" x 4"</u>	<u>10" x 2 3/4"</u>
Progress on Inspection	<u>Forged &amp; Smoothed</u>	<u>Forged &amp; Smoothed</u>	<u>Forged</u>
Dates when Inspected	<u>Nov 10<sup>th</sup> to Dec 21/91</u>	<u>March 3<sup>rd</sup> to May 9/92</u>	<u>Dec 26/91</u>

SKETCHES OF FRAMES SHEWING POSITION AND DESCRIPTION OF WELDS OF FORGINGS, OR PARTICULARS OF TESTS APPLIED TO CASTINGS.

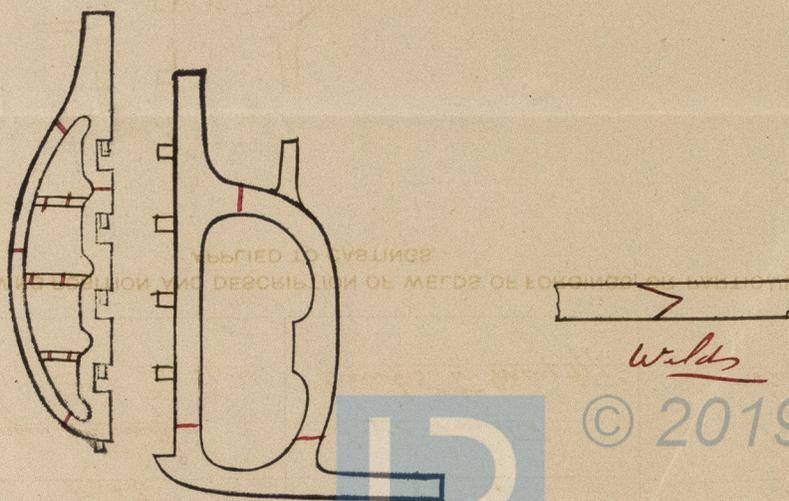

\* If of Iron, state whether scrap or puddled Iron.