


MORISON'S "SUSPENSION" FURNACES FOR BOILERS NO 969.

*See Furnace No. 969
Morison*

4 OFF



TO BE MADE OF BEST MILD STEEL TO PASS "LOYDS" FOR A WORKING PRESSURE OF 160 LBS PER SQUARE INCH.

SCALE 1/32" = 1 FOOT.

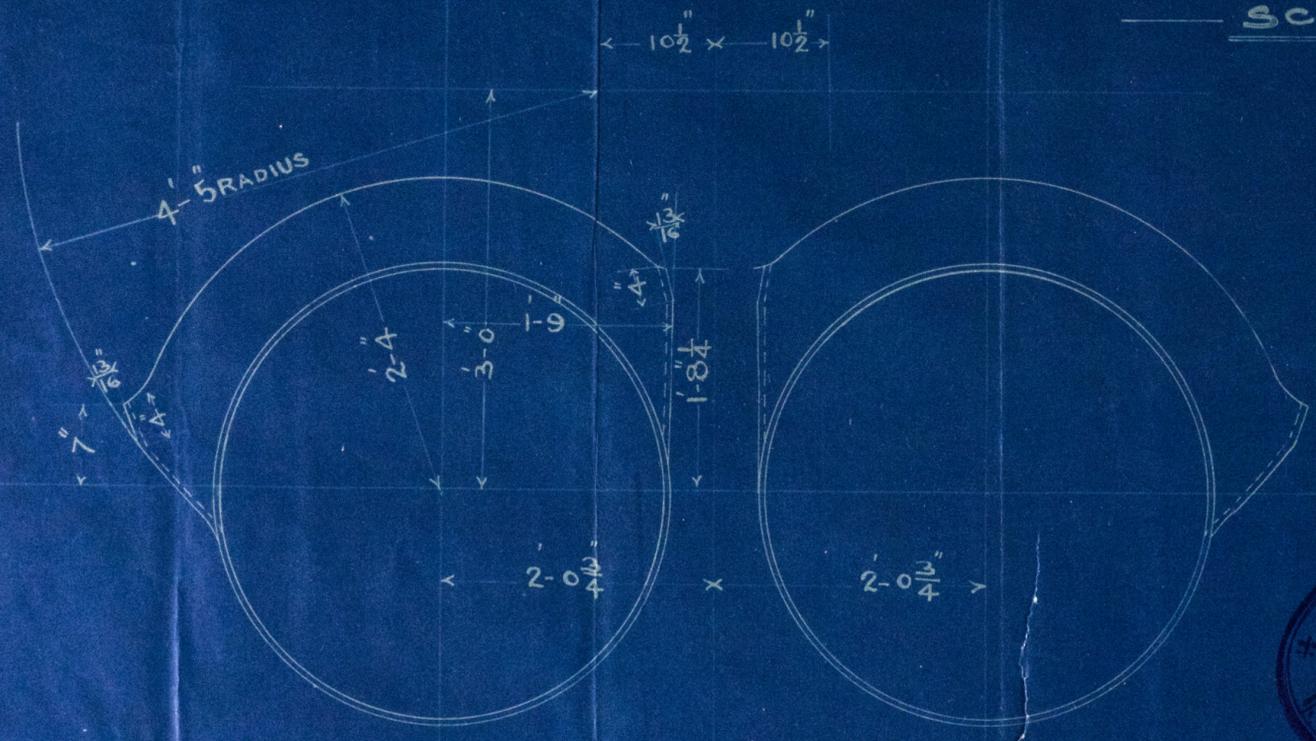

2 THUS LEFT HANDED.

2 THUS RIGHT HANDED.

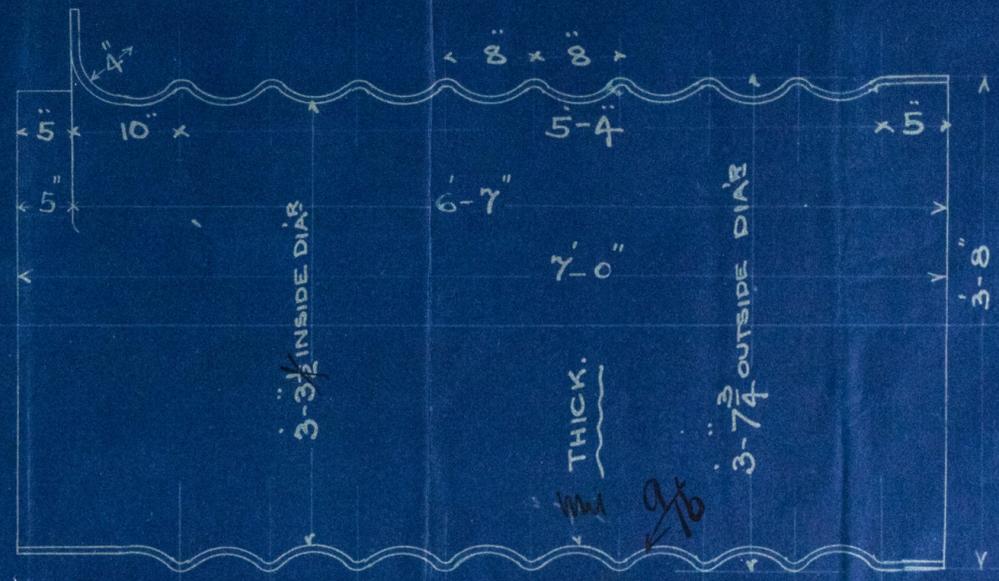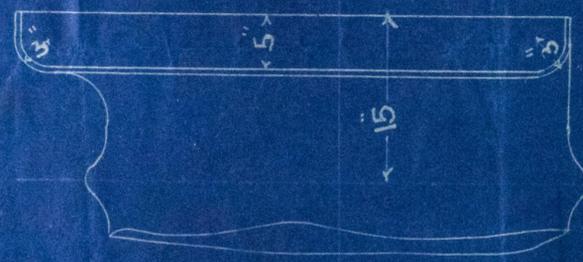

PLEASE BE PARTICULAR WITH THIS DIMENSION.

*W.A.
27-11-91*



Witting & Co 193

S. S. Glenwood,
W. Hope Report No. 8917.

HPL368-0050



© 2020

Lloyd's Register
Foundation