


26.7.92

PUMPING ARRANGEMENT

SCALE 1/8" = 1 FOOT

26.7.92

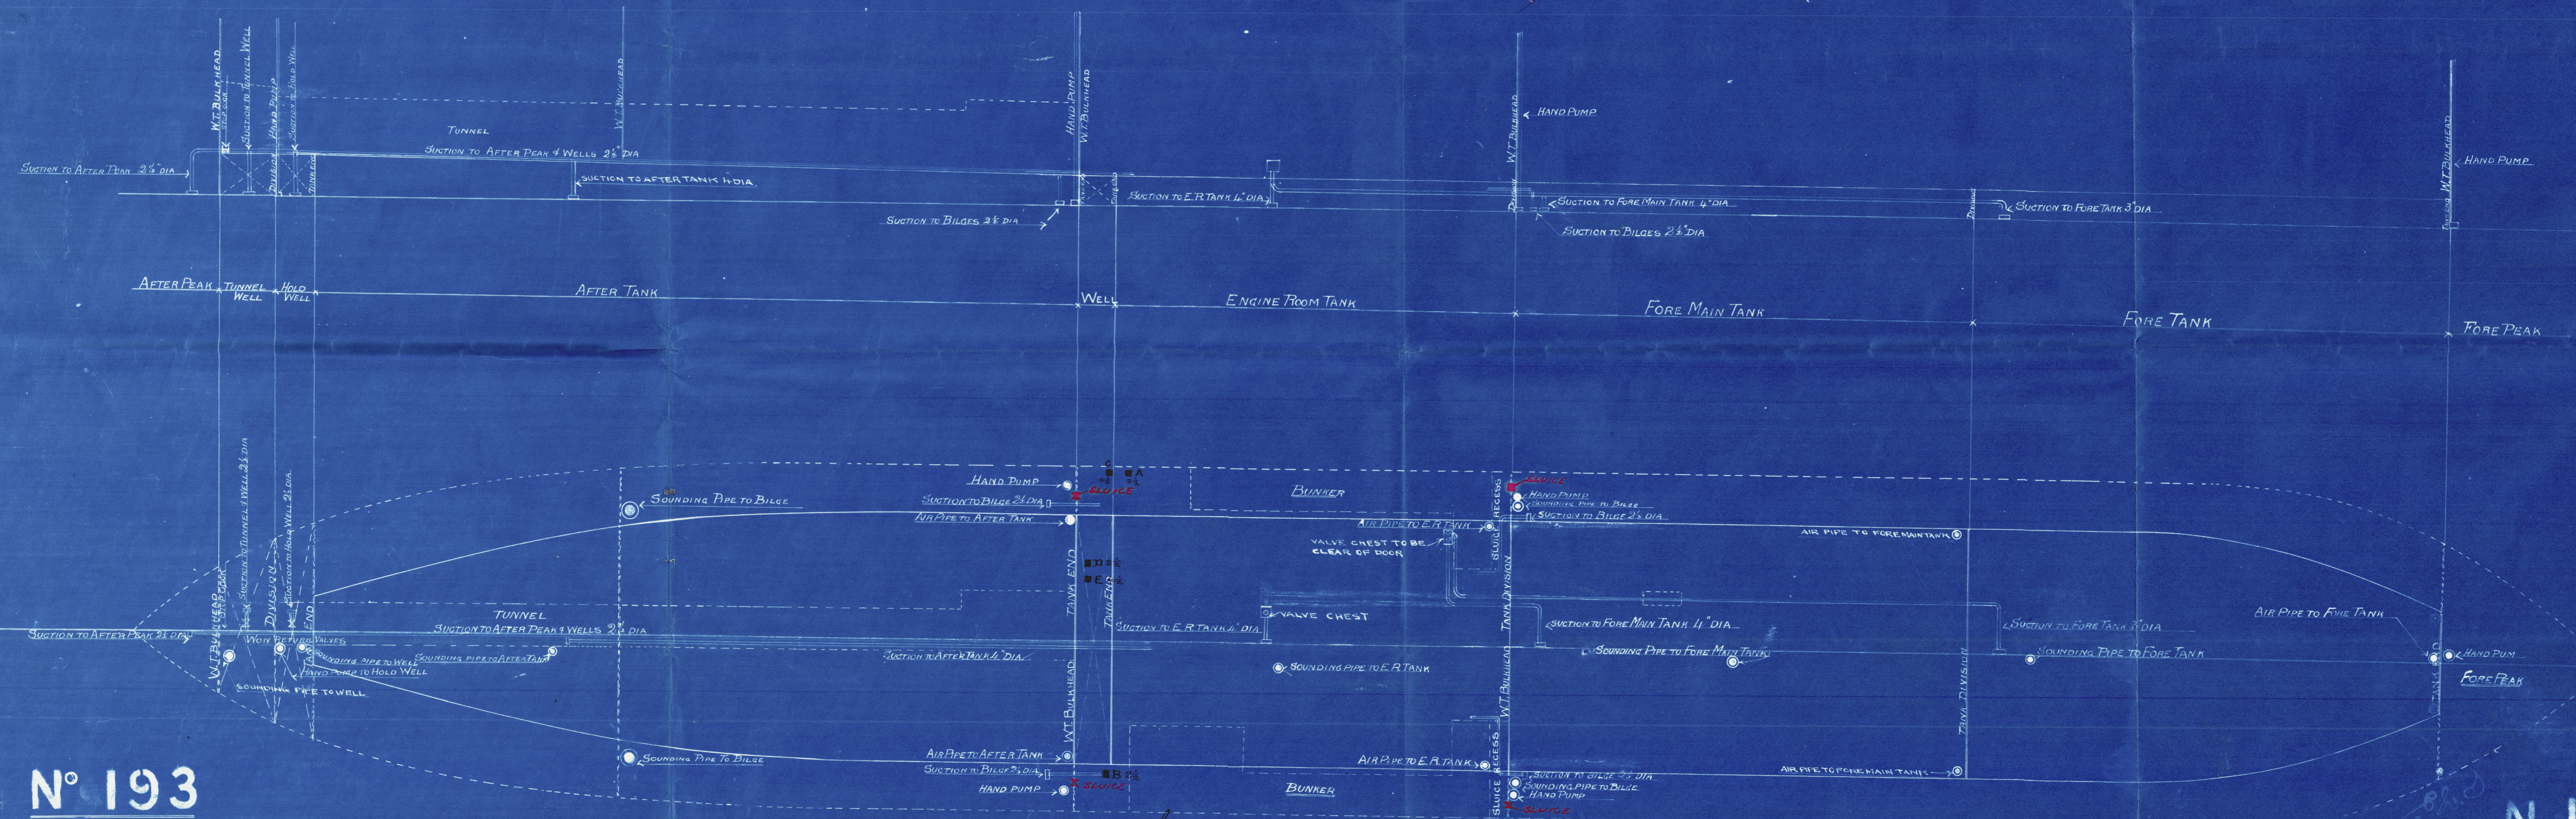

N° 193

A & B Main engines & feed donkeys.
 C " " (Bilge injection)
 D " " direct
 E " Ballast donkey "

July 25th 1892. J.R.S.

26.7.92

FURNESS, WITBY & CO. LIMITED
 SHIPBUILDERS & SHIPOWNERS
 WEST HARTLEPOOL

N 193



No 193

Pumping Arrangt.

Firness Wither & Co.

S.S. Glenwood,

W. Hpl. Report No 8917



HPL368-0051



© 2020

Lloyd's Register
Foundation