

The words FORGINGS or CASTINGS, IRON or STEEL, should be struck out as may be required.

*A. J. Glenwood*

Received at **WEST HARTLEPOOL** Office, *23<sup>rd</sup> May 1892*

# Lloyd's Register of British and Foreign Shipping.

*Wpool*

(Report on Vessel No. *8917* Port **WEST HARTLEPOOL.**)

## No. *2194.A.* SHIP FORGINGS ~~OR~~ CASTINGS.

I have to report that the undermentioned Iron ~~or Steel~~ Forgings ~~or Castings~~, manufactured by

*The Sunderland Forge Co.* of *Pallion*

for the Vessel No. *193*, being built by *Messrs Furness Withy & Co.*

of *Warrington* have been inspected by me as set forth below, and found to be, so far as can be seen, *sound*

Mark on Forgings.



**Lloyd's**

No. *2194.A*  
No. *C.*

*Wm Cameron*  
*Sunderland*

	STERN FRAME.	RUDDER FRAME.	STEM.
Material* - - -	<i>Scrap iron</i>	<i>Scrap iron</i>	<i>Scrap iron</i>
How made - - -	<i>Forged</i>	<i>Forged</i>	<i>Forged</i>
Dimensions - - -	<i>9' x 5"</i>	<i>7 1/4" - 3 1/2"</i>	<i>9' x 2 1/2"</i>
Progress on Inspection -	<i>Forged &amp; Smithed</i>	<i>Forged &amp; Smithed</i>	<i>Forged</i>
Dates when Inspected	<i>Jan 13<sup>th</sup> to Feb 23/92</i>	<i>March 11<sup>th</sup> to May 20/92</i>	<i>March 2/92</i>

SKETCHES OF FRAMES SHEWING POSITION AND DESCRIPTION OF WELDS OF FORGINGS, OR PARTICULARS OF TESTS APPLIED TO CASTINGS.

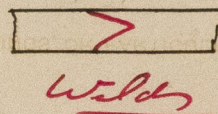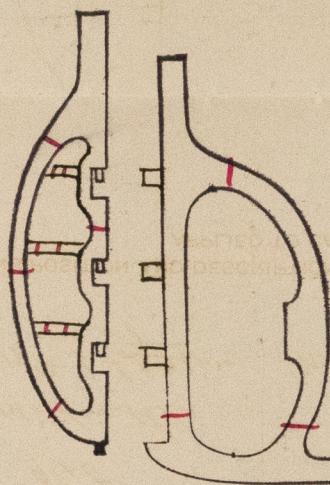

© 2019

Lloyd's Register  
Foundation