


MIDSHIP SECTION

2.12.91.

SCALE $\frac{1}{2}'' = 1 \text{ FOOT}$

S. S. "Glenwood"

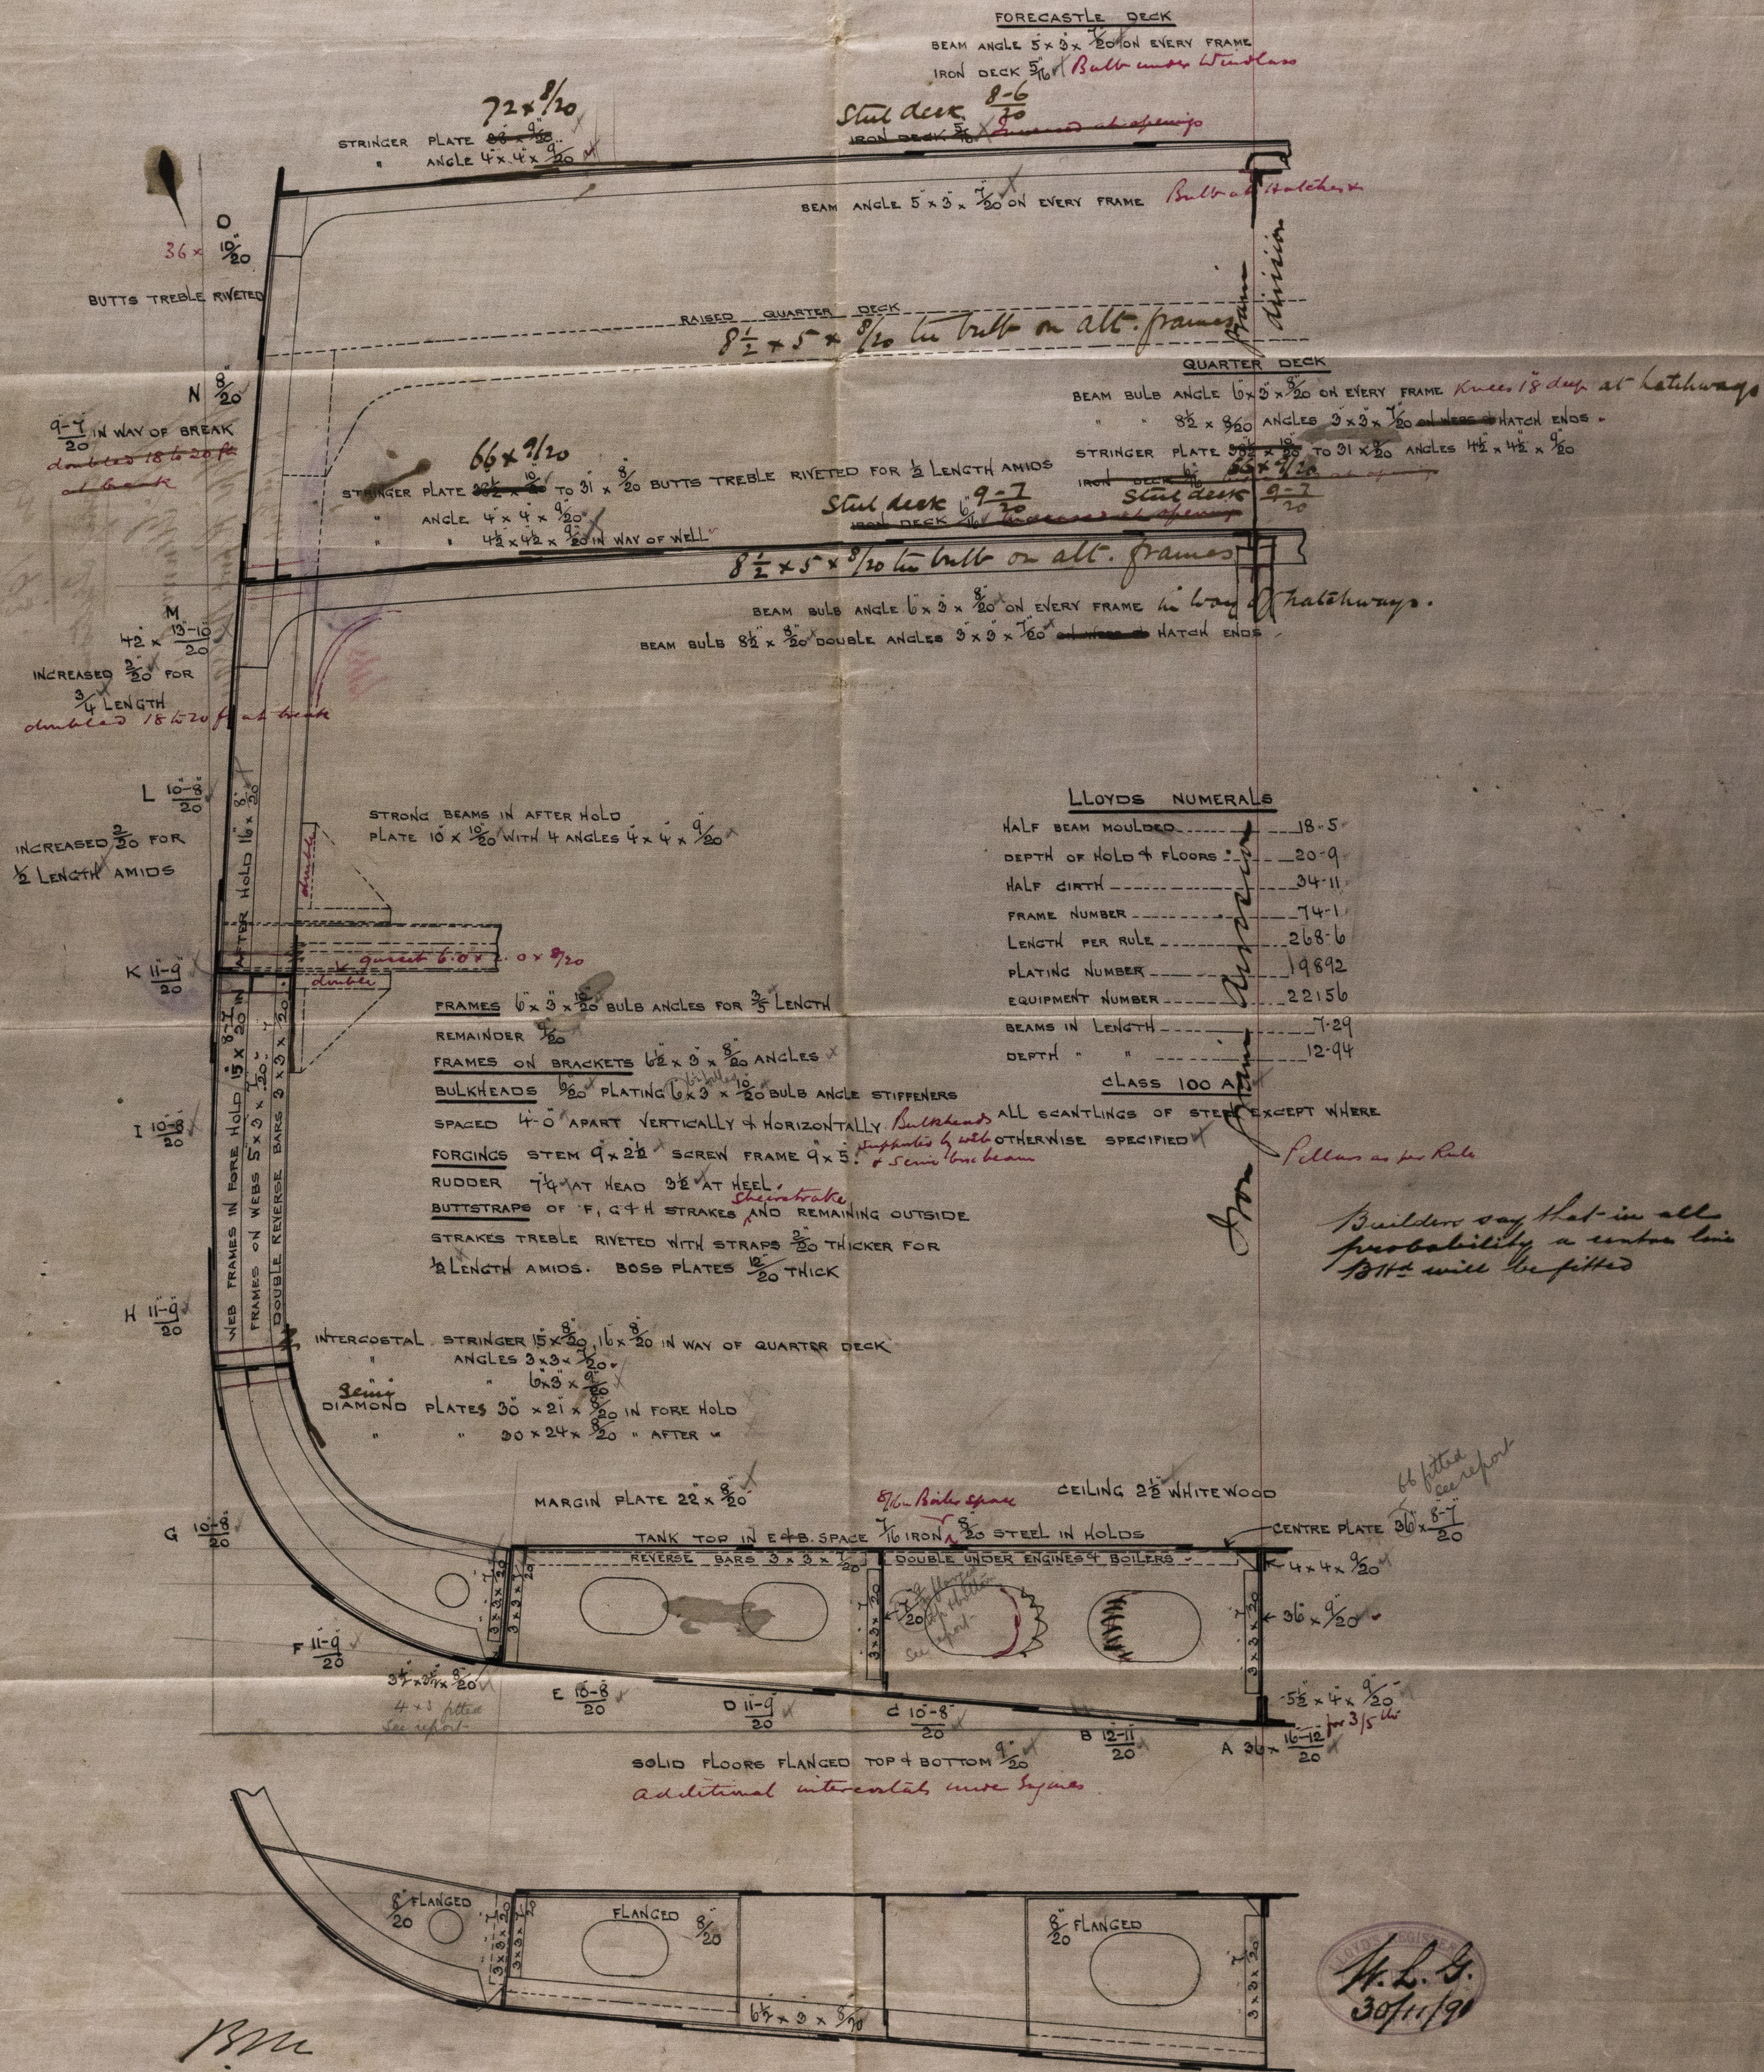

S. S. N^o 193

FURNESS, WITNEY & CO., LIMITED
SHIPBUILDERS & SHIPREPAIRERS,
WEST HARTLEPOOL.
TRACING No. 10500
NOV 25/91



Lloyd's Register
Foundation

Furness Wharf No.

Dec 193.

Machine Section

S.S. Glenwood

W. Hpl. Report No 8894

No 1st Entry No.



8914

HPL3680055

© 2020

Lloyd's Register
Foundation