


2.12.91.

PROFILE.
SCALE $\frac{1}{8}" = \text{ONE FOOT.}$

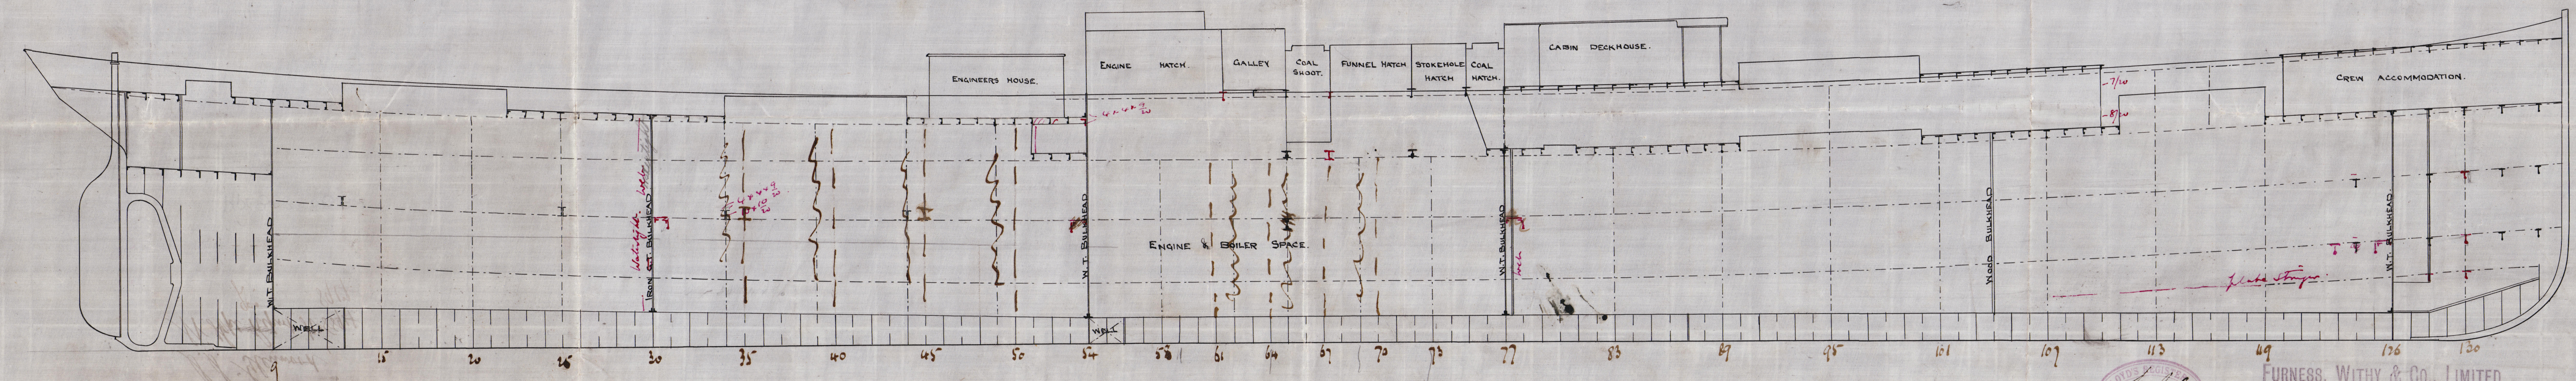


Nº 193

YBM
2/12/91



FURNESS, WITBY & CO., LIMITED.
SHIPBUILDERS & SHIPOWNERS,
WEST HARTLEPOOL.
Nov^r 17th 1891.

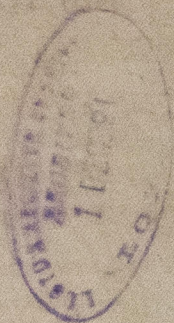

Jumess Writing Co.

No. 193

Profile

19/1/33


No 193

H. S. Glenwood


W. H. R. Report No 8894

8917

8917

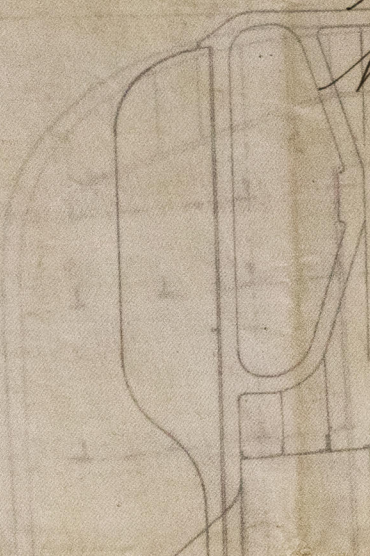

HPL368-0058

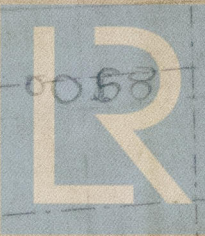

© 2020

Lloyd's Register
Foundation