



RULE SIZE OF STRINGER $40 \times \frac{10}{20} = 400$ AREA
 PROPOSED SIZE OF STRINGER $70 \times \frac{9}{20} = 630$ AREA

BRIDGE DECK

SCALE $\frac{1}{4}'' = 1$ FOOT

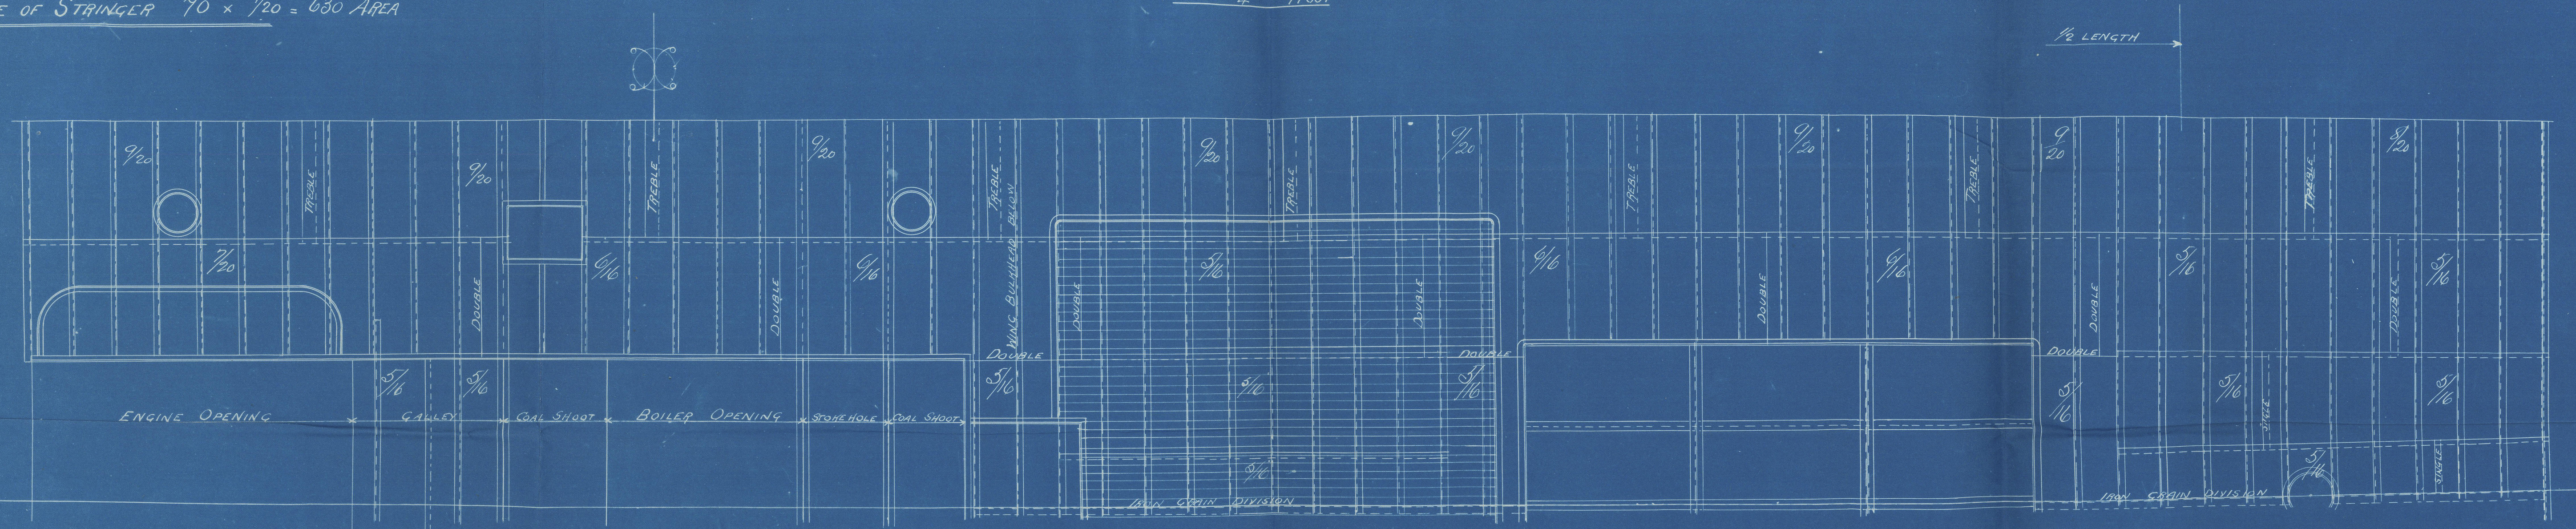

Nº 194

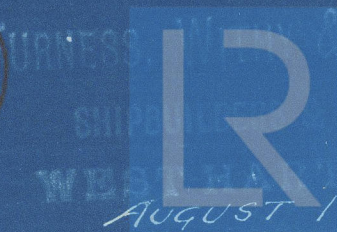

LLOYD'S REGISTER OF SHIPPING
 AUGUST 13TH 1892

HPL 369-0023

Furness Writing & Co.

Dec. 194

Bridge deck plating

S.S. "Cardinal"

W. Hpl. Report No 8970.

HPL369-0023



© 2020

Lloyd's Register
Foundation