

Lloyd's Register of British and Foreign Shipping.

(Report on Vessel No. *8970* Port **WEST HARTLEPOOL**.)

Wpool

No. *2195-a* **SHIP FORGINGS OR CASTINGS.**

The words FORGINGS or CASTINGS, IRON or STEEL, should be struck out as may be required.

I have to report that the undermentioned Iron ~~or Steel~~ Forgings ~~or Castings~~, manufactuerd by *The Sunderland Forge Co.* of *Felling* for the Vessel No. *194*, being built by *Wm^r Turner & Co* of *Hartlepool* have been inspected by me as set forth below, and found to be, so far as can be seen, *sound*.

Mark on Forgings.


Lloyd's
No. *2195-a*
No 6

Rush Cameron

Sunderland
22. 8. 92

| | STERN FRAME. | RUDDER FRAME. | STEM. |
|--------------------------|---|---|---------------------|
| Material* - - - | <i>Scrap iron</i> | <i>Scrap iron</i> | <i>Scrap iron</i> |
| How made - - - | <i>Forged</i> | <i>Forged</i> | <i>Forged</i> |
| Dimensions - - - | <i>10' x 5 1/2"</i> | <i>7 3/4' - 3 3/4'</i> | <i>10" x 2 1/2"</i> |
| Progress on Inspection - | <i>Forged & smithed</i> | <i>Forged & smithed</i> | <i>Forged</i> |
| Dates when Inspected | <i>Jan^y 13th to Feb 27/92</i> | <i>Feb 25th to Aug^t 10/92</i> | <i>March 2/92</i> |

SKETCHES OF FRAMES SHEWING POSITION AND DESCRIPTION OF WELDS OF FORGINGS, OR PARTICULARS OF TESTS APPLIED TO CASTINGS.

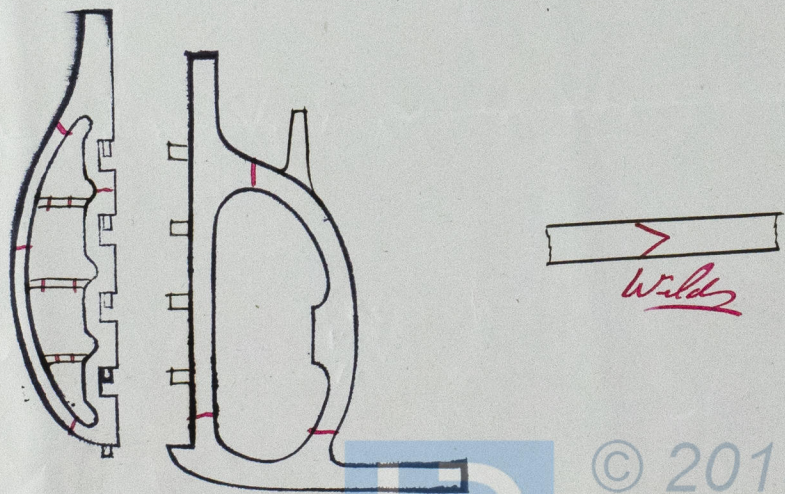

* If of Iron, state whether scrap or puddled Iron.