

Furness writing 16/9/1944

60th ¹⁰ Express

S.S. "Cardinal"

W. Npl. Report No. 8970


HPL369-0026



© 2019

Lloyd's Register
Foundation

THOMAS SUDDRON & Co., Limited
IMPERIAL BOILER WORKS,
STOCKTON-ON-TEES.

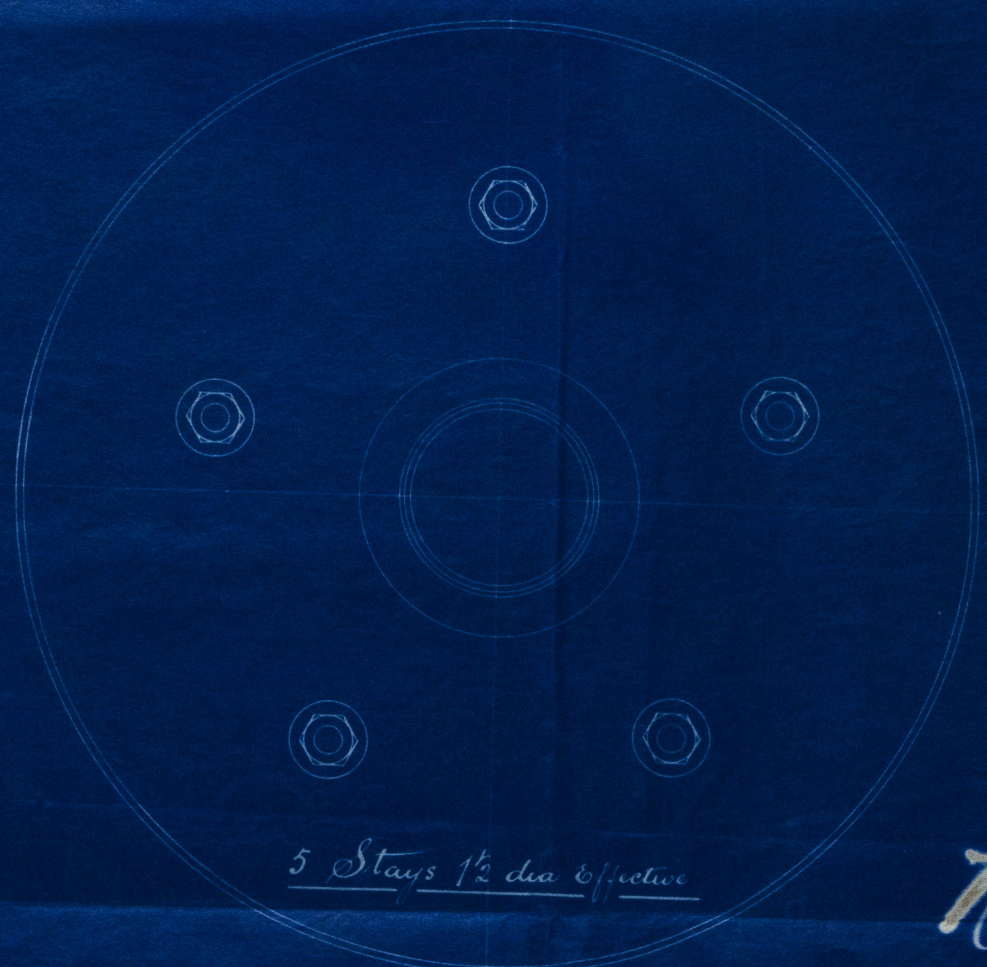

No 548.

STEEL VERTICAL DONKEY BOILER.

11'0" x 5'6"

SCALE 1 INCH TO ONE FOOT


No 548

Messrs TURNER, WILBY & CO. LTD


No 194 S.S.

TO PASS LLOYD'S SURVEY

WORKING PRESSURE 60 LBS SQ IN

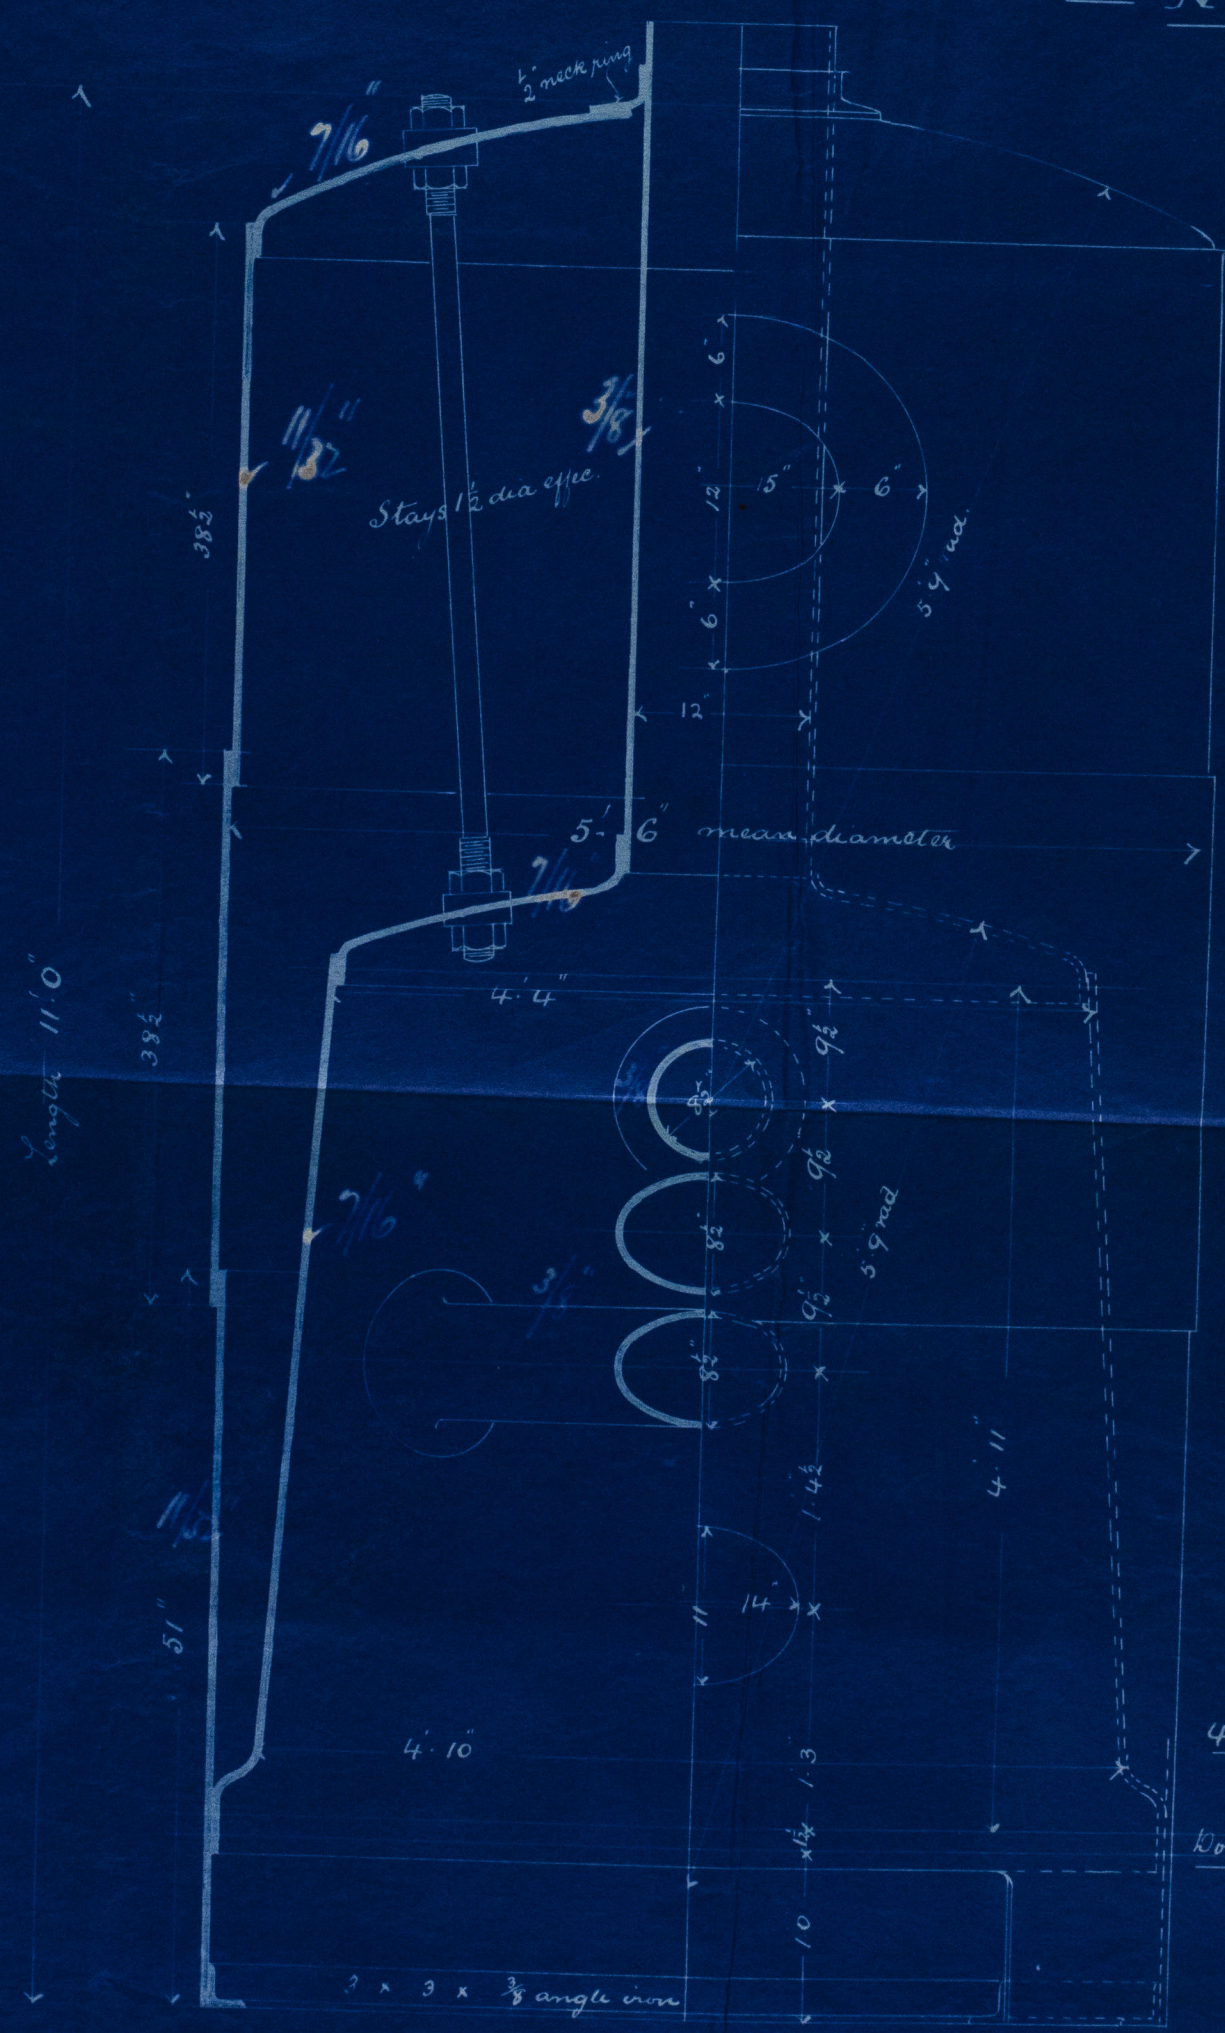

One hand hole at one end of each cross tube

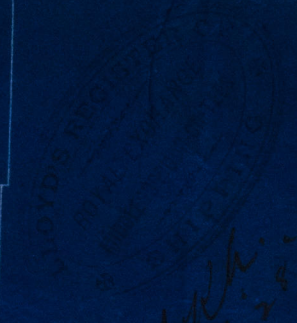

W. H. 15th July 1892

4 mud holes round base

Double riveted seam.

Circular Seams single riveted 13/16 Rivets 2" Pitch.
Vertical " double 13/16 " 2 3/4"

30/4/92.



© 2019

Lloyd's Register Foundation

HPL 548 0026