

Dec 29 8 92

PUMPING ARRANGEMENT

SCALE 1/8" = 1 FOOT

Section dated
29 2 92.




N^o 194

A+B Main engine & fuel donkey.
C " " direct (bilge injection)
D " " (bilge pumps)
E Ballast donkey direct.

Aug 26 1892
R.R.

NA.
29 8 92

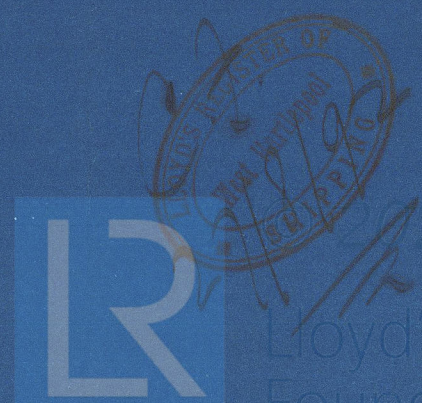

Lloyd's Register
Foundation
HPL 369-0023

Gurness, Worthy, & Co.
No. 194

Pumping plan.



S.S. "Cardinal"
W. Hpl. Report No. 897.

HPL 369-0028



© 2020

Lloyd's Register
Foundation