


29.2.92  
9.8.92

# PROFILE


Scale  $\frac{1}{8}$  = 1 foot.

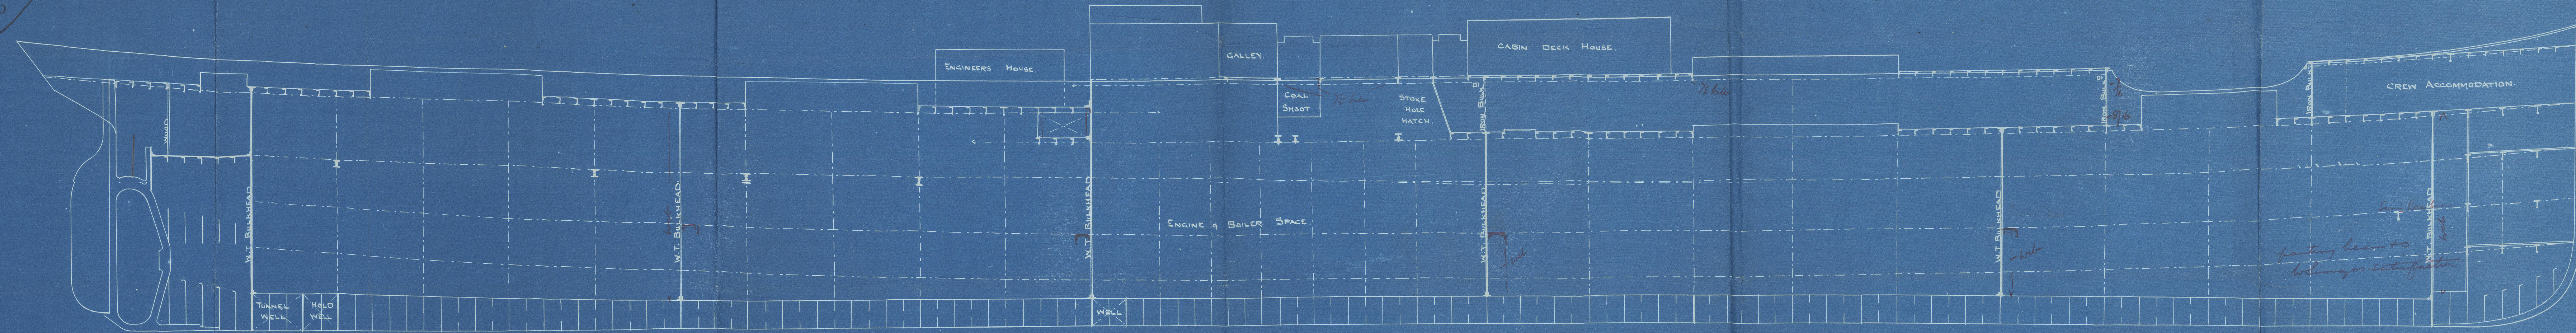

S.S. N<sup>o</sup> 194.

FURNESS, WITBY & CO., LIMITED  
SHIPBUILDERS & SHIPOWNERS.  
WEST HARTLEPOOL

TRACING N<sup>o</sup> 10683.  
FEBRUARY 23<sup>rd</sup> 1902.

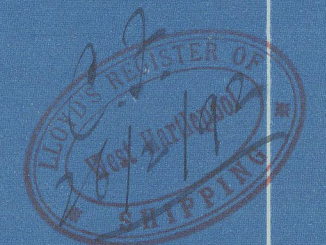

Lloyd's Register  
Foundation

HPL 369-0029



Furness Writing Co.

S.S. No. 194

Amended Profile



Report No. 8957



S.S. Cardinal  
W. Hope. Report No. 8970.

HPL 369-0029



© 2020

Lloyd's Register  
Foundation