

QUARTER DECK


RULE SIZE OF STRINGER $4\frac{1}{2} \times \frac{12-8}{20}$
 PROPOSED SIZE OF STRINGER $7\frac{1}{2} \times \frac{11-8}{20}$

SCALE $\frac{1}{4}'' = 1 \text{ FOOT}$

$\frac{3}{8}$ LENGTH $\frac{1}{2}$ LENGTH

4.8.92
6.10.92

3/5 197
16.11.92
3/5 198
10.12.92

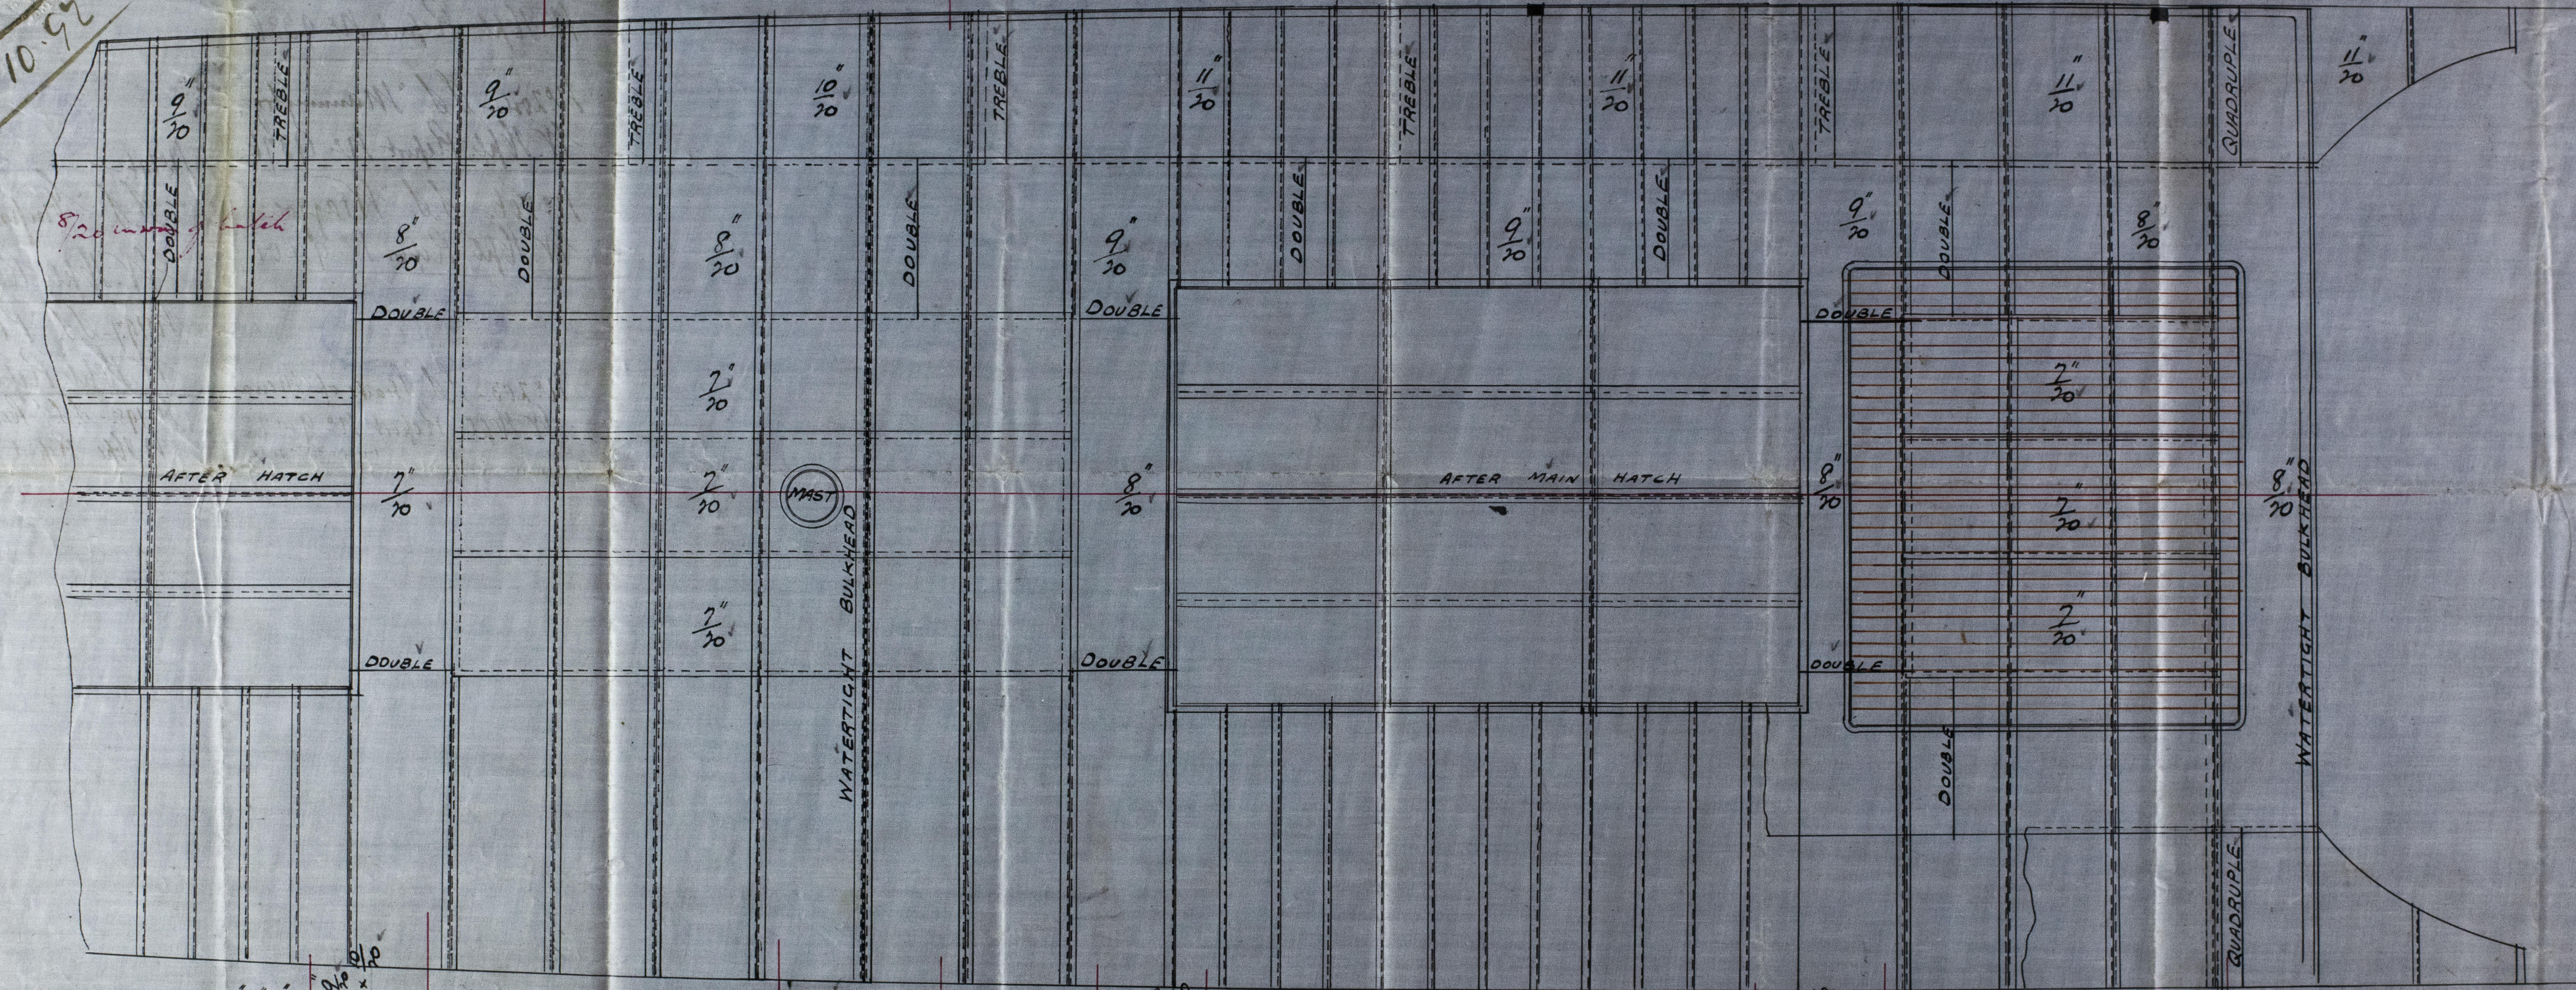

BULB ANGLES $6\frac{1}{2} \times 3 \times \frac{9}{20}$
 BULB $9 \times \frac{9}{20}$ ANGLE $3\frac{1}{2} \times 3 \times \frac{9}{20}$
 OR BULB TEES OF EQUIVALENT SECTION
 BULB $9 \times \frac{9}{20}$ ANGLE $3\frac{1}{2} \times 3 \times \frac{9}{20}$
 OR BULB TEES OF EQUIVALENT SECTION
 BULB ANGLES $6\frac{1}{2} \times 3 \times \frac{9}{20}$
 BULB $9 \times \frac{9}{20}$ ANGLE $3\frac{1}{2} \times 3 \times \frac{9}{20}$
 OR BULB TEE OF EQUIVALENT SECTION
 BULB $9 \times \frac{9}{20}$ ANGLE $3\frac{1}{2} \times 3 \times \frac{9}{20}$
 OR BULB TEE OF EQUIVALENT SECTION

4/8
6/10/92

REGISTERED
SHIPBUILDERS & SHIPOWNERS
WEST HARTLEPOOL
19th July 1892

FURNESS, WITBY & CO., LIMITED.
 SHIPBUILDERS & SHIPOWNERS,
 WEST HARTLEPOOL.
 19th July 1892
 HPL369-0077

Q U A R T E R

Furness Withy & Co
~~No. 196~~
Quarter deck.

No. 205. S.S. "Madeline",
W. Hpl. Report No. 9336.

No. 204. S.S. "Manningtrey",
W. Hpl. Report No. 9376.

No. 206. S.S. "Waggon",
W. Hpl. Report No. 94401.

No. 203. S.S. "Straits of Menai",
W. Hpl. Report No. 94478
over 3rd side

No. 196. S.S. "Empress",
W. Hpl. Report No. 90044.

No. 197. S.S. "Plympton",
W. Hpl. Report No. 9102.

No. 198. S.S. "Keltisloe",
W. Hpl. Report No. 9122.

HPL 369-0077

FURNESS WITHY & CO. LIMITED
W. Hpl. Report No. 94478
No. 203. S.S. "Straits of Menai"
Lloyd's Register
Foundation