


Turner & Co.
No. 198.

Iron masts.

S. S. "Compass"
W. H. P. R. 9004

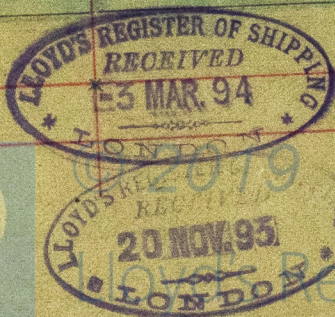

HPL369-0082

SKETCH OF IRON LOWERNASTS



SCALE $\frac{1}{4}$ " = ONE FOOT

For Messrs Furness, Withy, & Co Limited N° 196 S.S.

Note! Masts to be made in two plates in the round
Seams single riveted, Straps in housing double riveted, remainder triple
Straps to thicker than plates they connect.

From Partners to Land top 30 feet.

From Partners to Land top 26 feet.

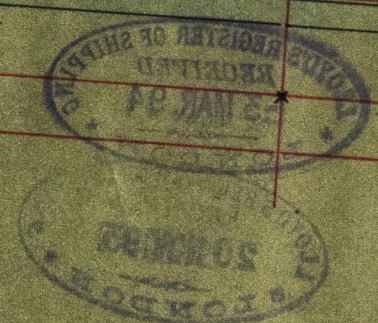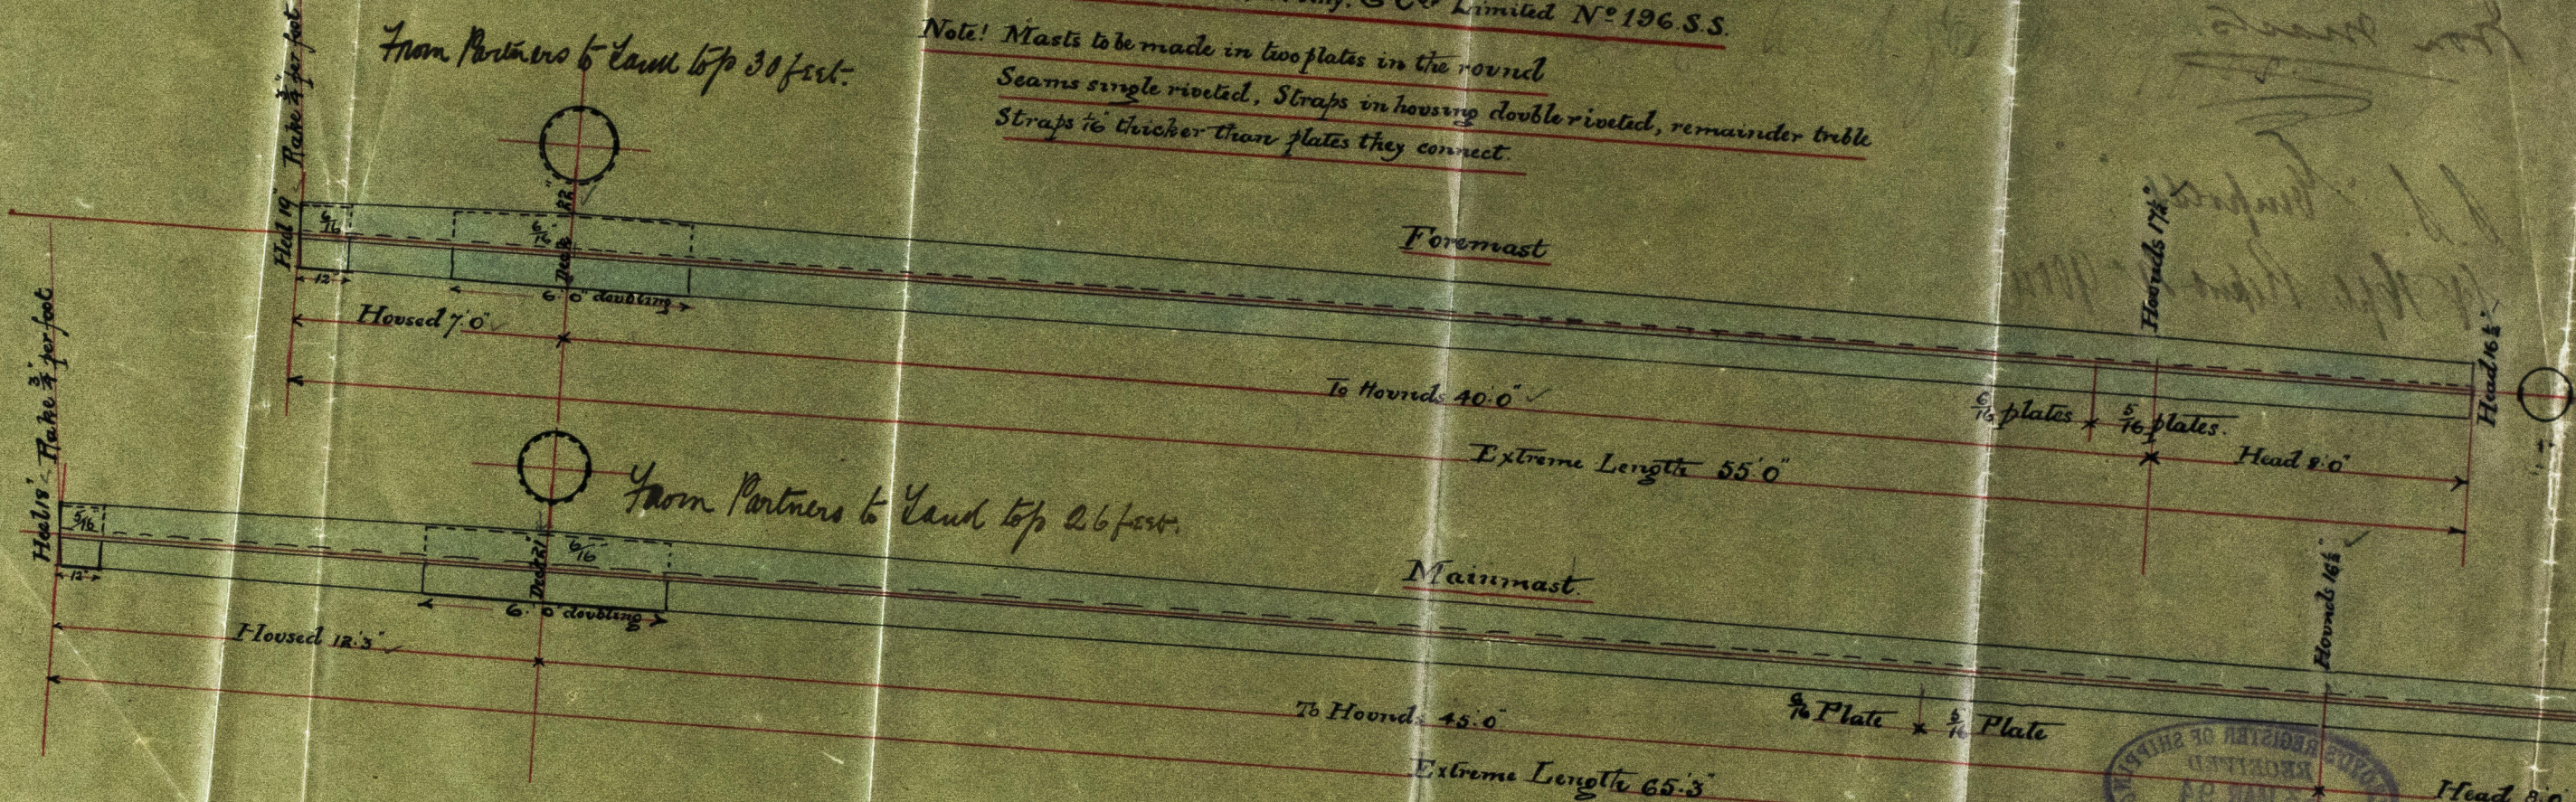

HPL 369-0082