

Empress

Received at **WEST HARTLEPOOL** Office

29th Oct 1892

Lloyd's Register of British and Foreign Shipping.

W. Pool

(Report on Vessel No. *9001* Port **WEST HARTLEPOOL**.)

No. *2359.a*

SHIP FORGINGS OR CASTINGS.

The words FORGINGS or CASTINGS, IRON or STEEL, should be struck out as may be required.

I have to report that the undermentioned Iron or Steel Forgings or Castings, manufactured by

The Stratton Forge Co. of *Stratton*

for the Vessel No. *196*, being built by *Mr James Kirby & Co.*

of *Wartlepool* have been inspected by me as set forth below, and found to be, so far as can be seen, *sound*.


Mark on Forgings.

Lloyd's
No. *2359a*
No. *6*

Wm. Laman
Sunderland
28. 10. 92

	STERN FRAME.	RUDDER FRAME.	STEM.
Material*	<i>Scrap iron</i>	<i>Scrap iron</i>	<i>Scrap iron</i>
How made	<i>Forged</i>	<i>Forged</i>	<i>Forged</i>
Dimensions	<i>10" x 6"</i>	<i>8" x 4"</i>	<i>10" x 2 3/4"</i>
Progress on Inspection	<i>forged & smithed</i>	<i>forged & smithed</i>	<i>forged</i>
Dates when Inspected	<i>July 26th to Aug 23/92</i>	<i>Aug 23rd to Oct 24/92</i>	<i>July 26/92</i>

SKETCHES OF FRAMES SHEWING POSITION AND DESCRIPTION OF WELDS OF FORGINGS, OR PARTICULARS OF TESTS APPLIED TO CASTINGS.

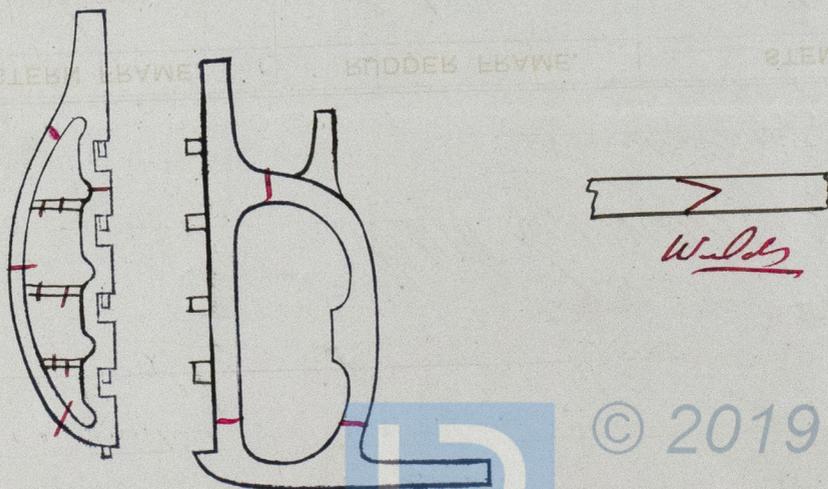

* If of Iron, state whether scrap or puddled Iron.

