


MIDSHIP SECTION

J. J. Plympton

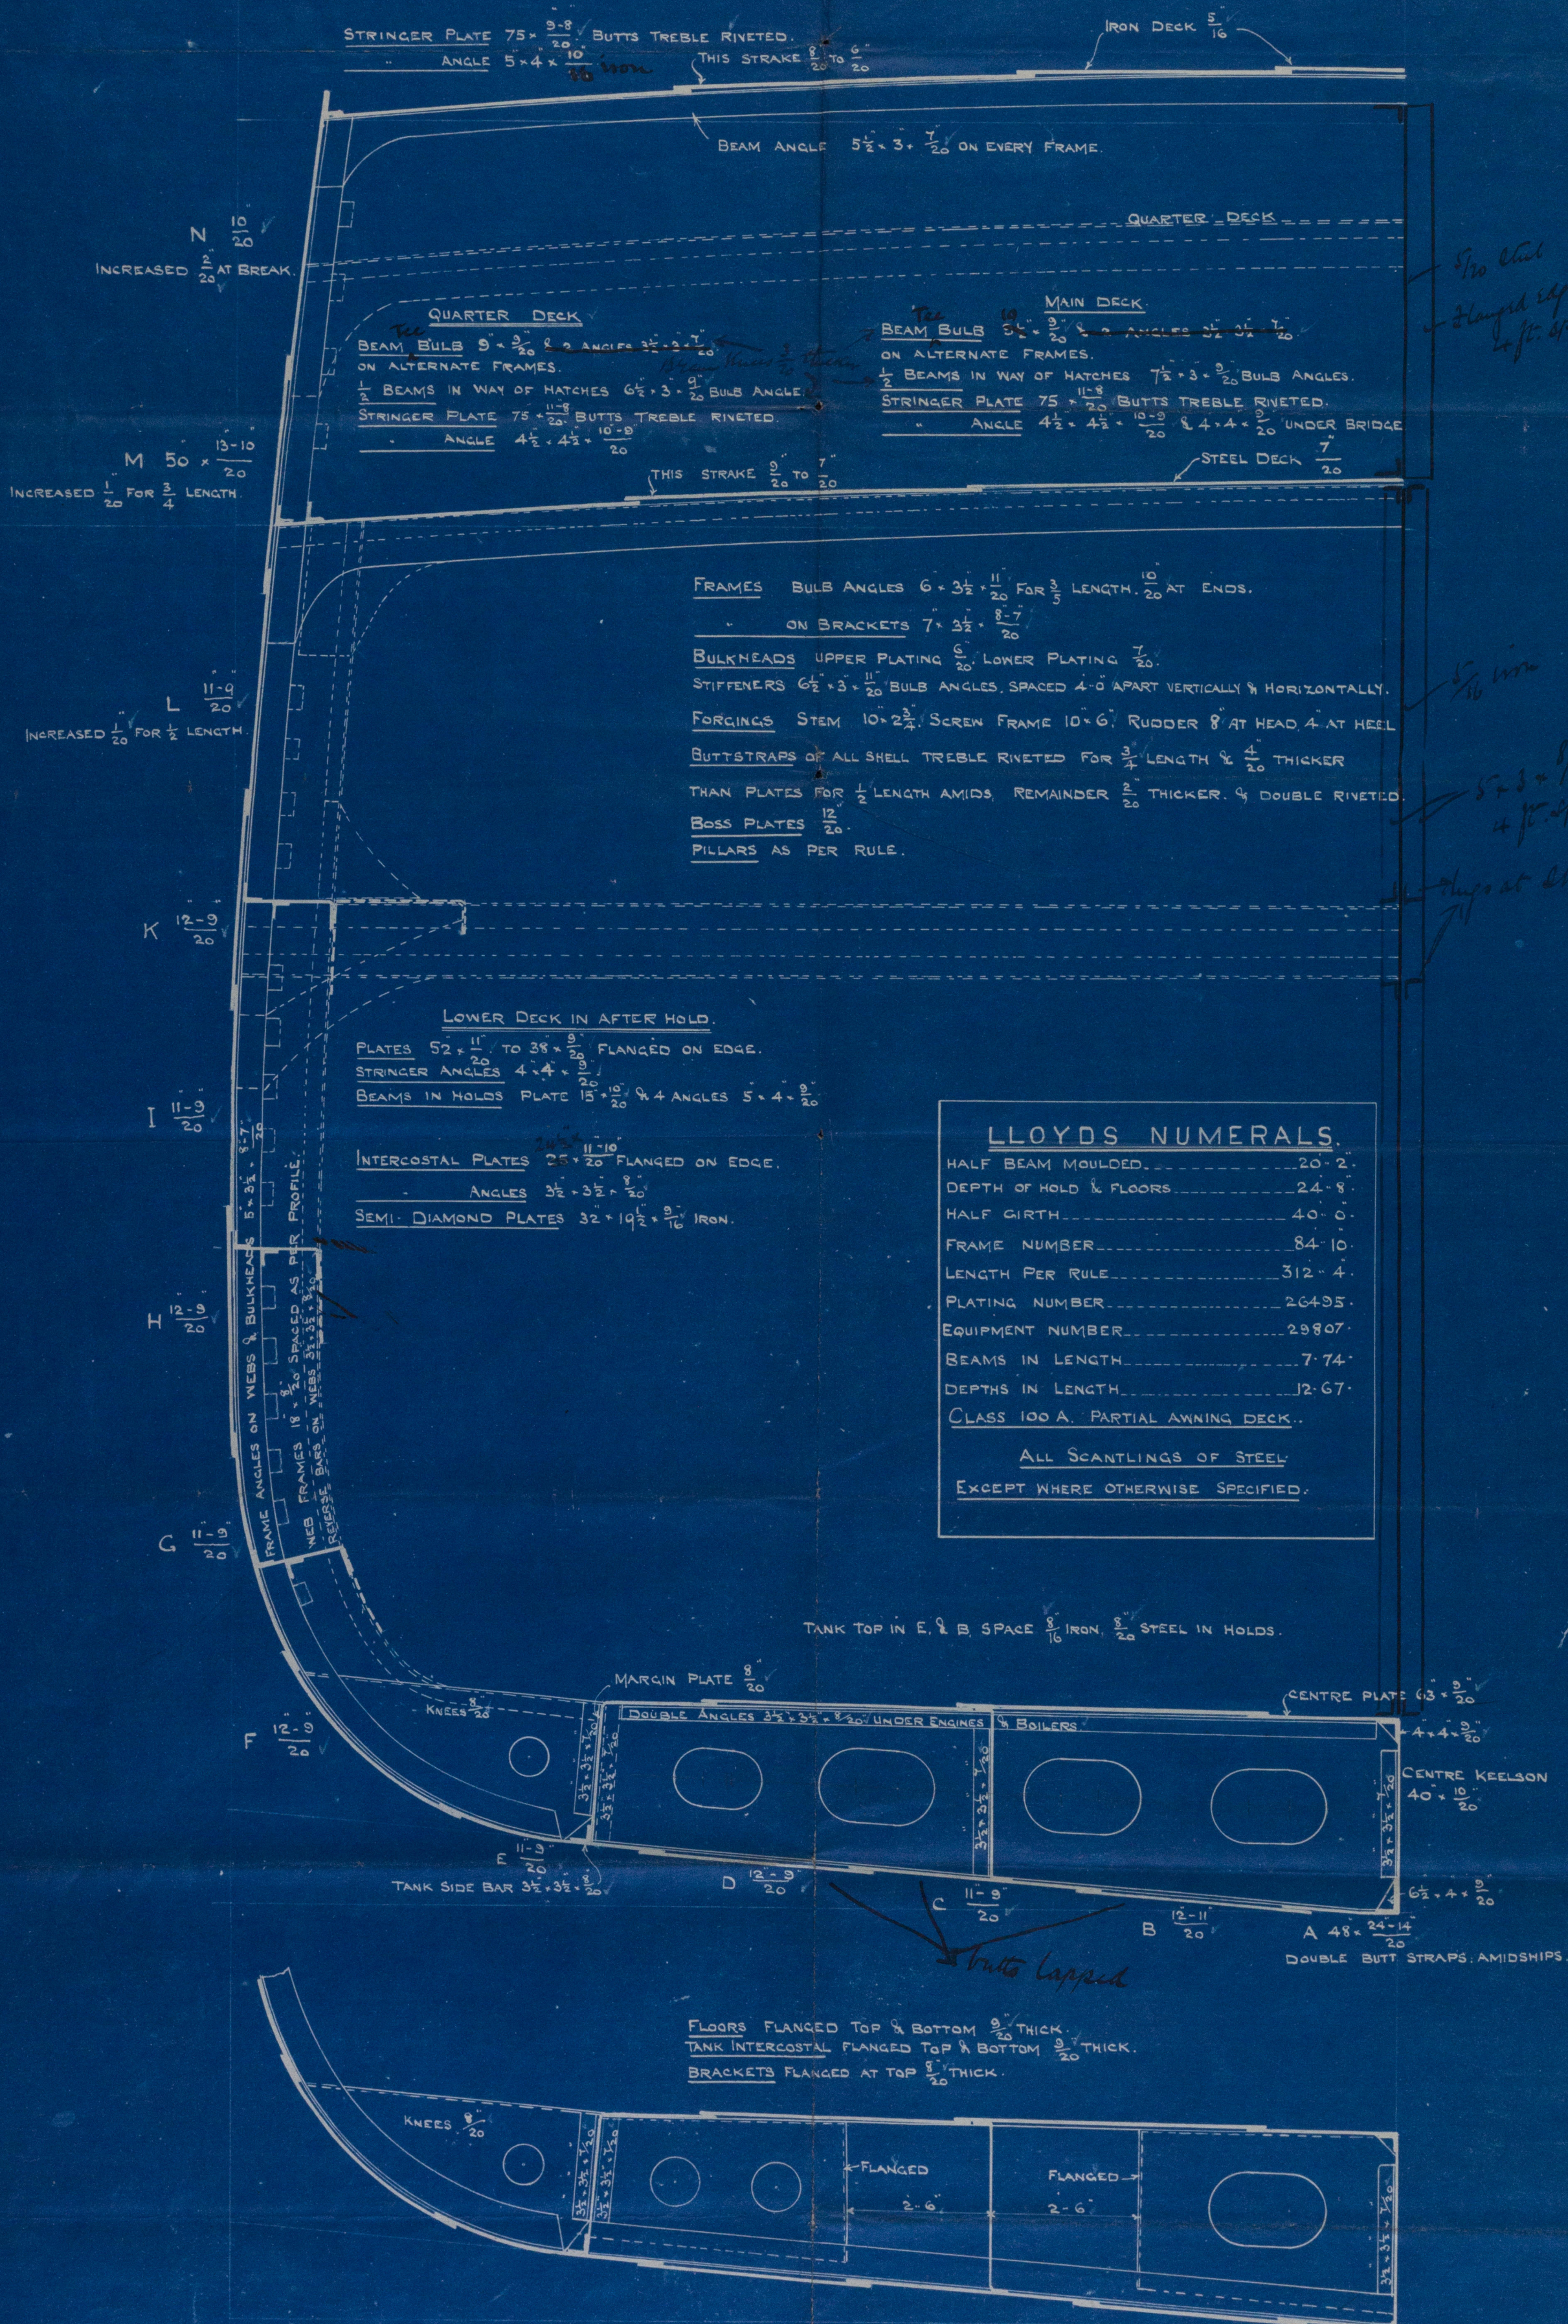

S.S. N^o 197.

Engine approved
John



FURNESS, WITBY & CO., LIMITED
SHIPBUILDERS & SHIPPOWERS,
WEST BARTLEPOOL.
TRACING N^o 11259.
FEBRUARY 26th 1933.

WPL 370-0004

Midship Section

Burness, Withy & Co's

No 197.

S.S. Plympton

W. Hpl. Report No. 91672



HPL370-0014



© 2019

Lloyd's Register
Foundation