


SKETCH of IRON LOWERMASTS

For Messrs FURNESS, WITHY & CO'S No 198 S.S.


Scale $\frac{1}{4}$ " = One foot.

Similar masts approved for No 196 S.S.

FOREMAST

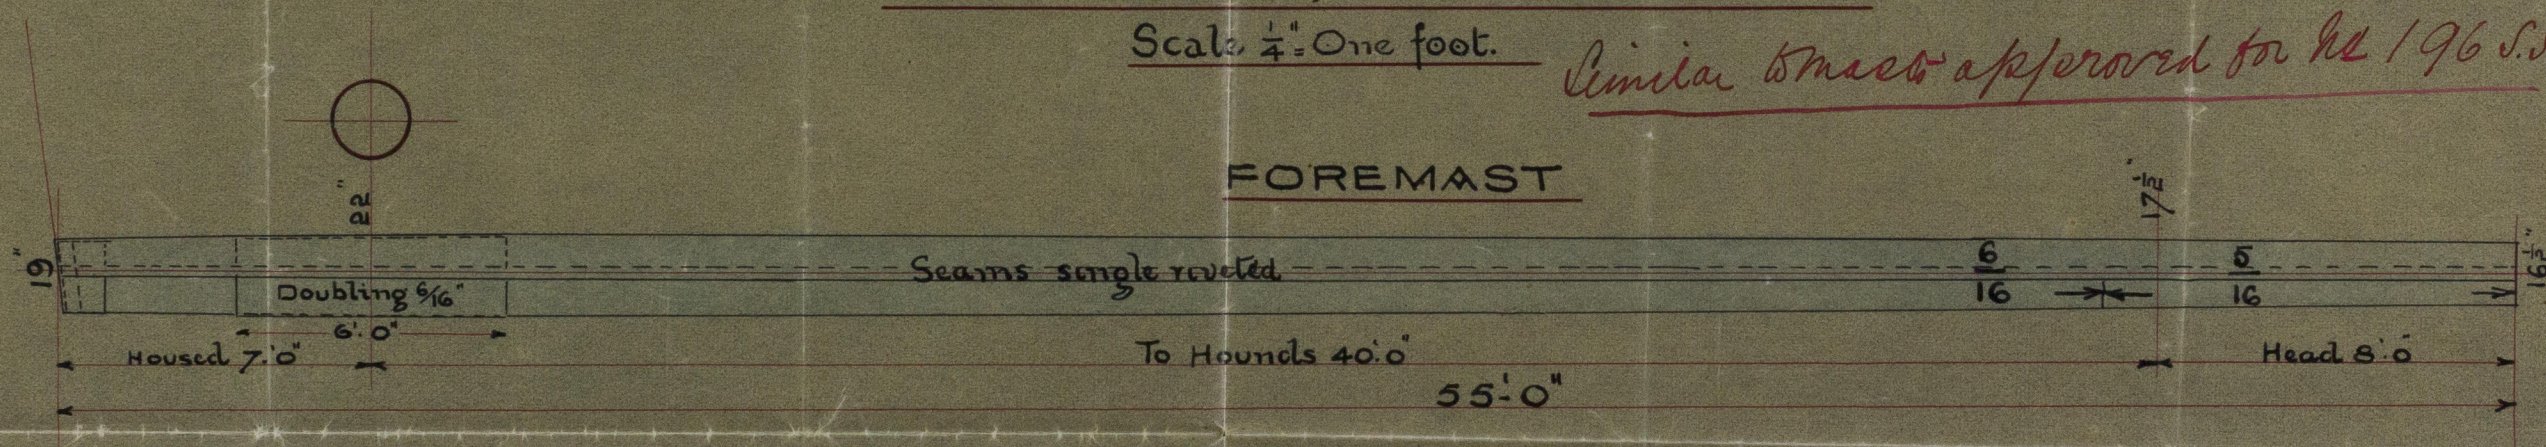

MAINMAST

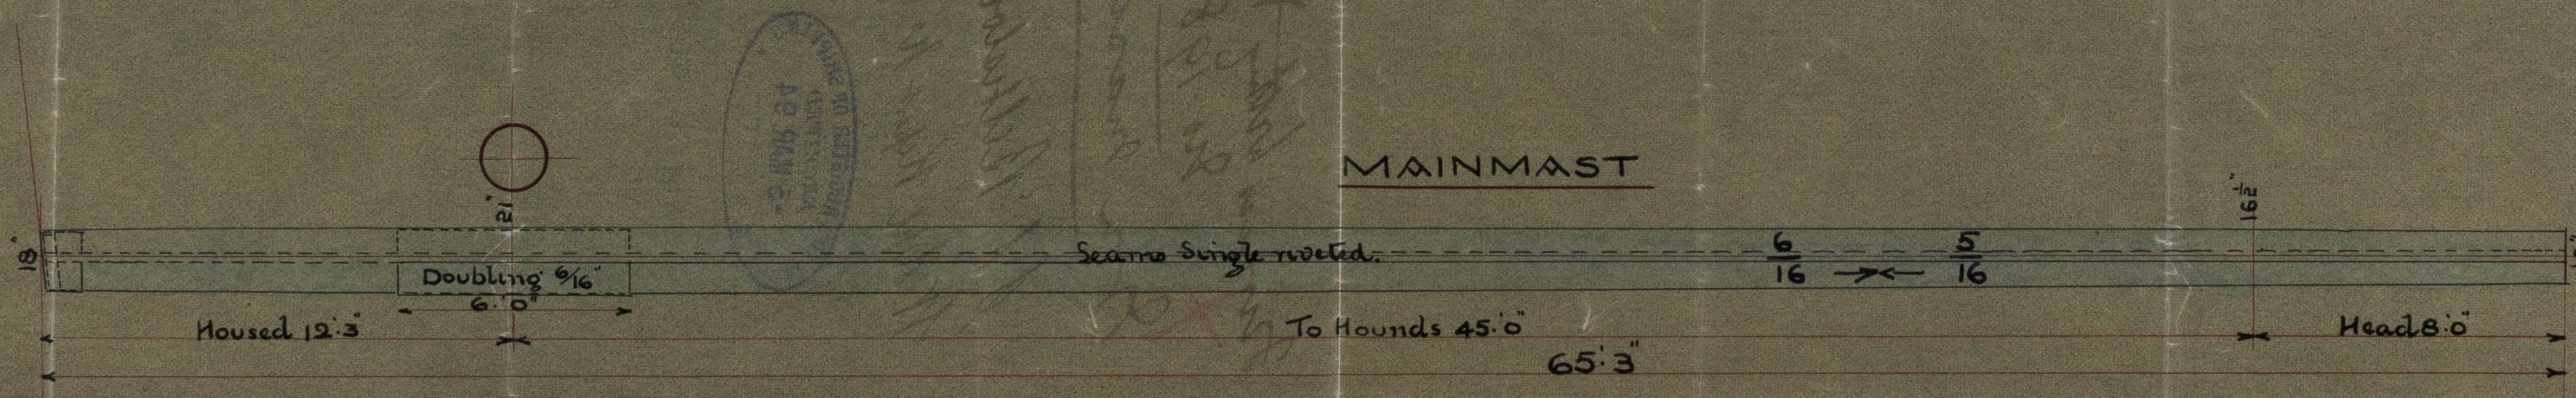

Note. Masts made in 2 plates in the round
 Straps $\frac{1}{8}$ " thicker than the plates they connect & fitted inside
 " double riveted below, keble riveted above deck

THOMAS SUDRON & Co., Limited
 IMPERIAL BOILER WORKS,
 STOCKTON-ON-TEES.




Lloyd's Register
 Foundation


James W. H. Co.
No. 198

Iron masts.

S. S. 'Bellisloe',
W. H. P. Report No. 9122

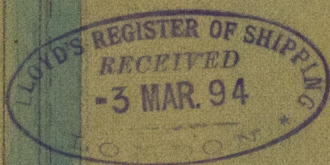

HP 370 - 0069

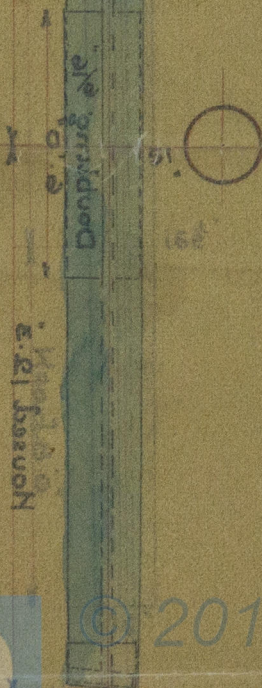

Don't see

© 2019

Lloyd's Register
Foundation