


# MIDSHIP SECTION

S.S. "Bellisloe."

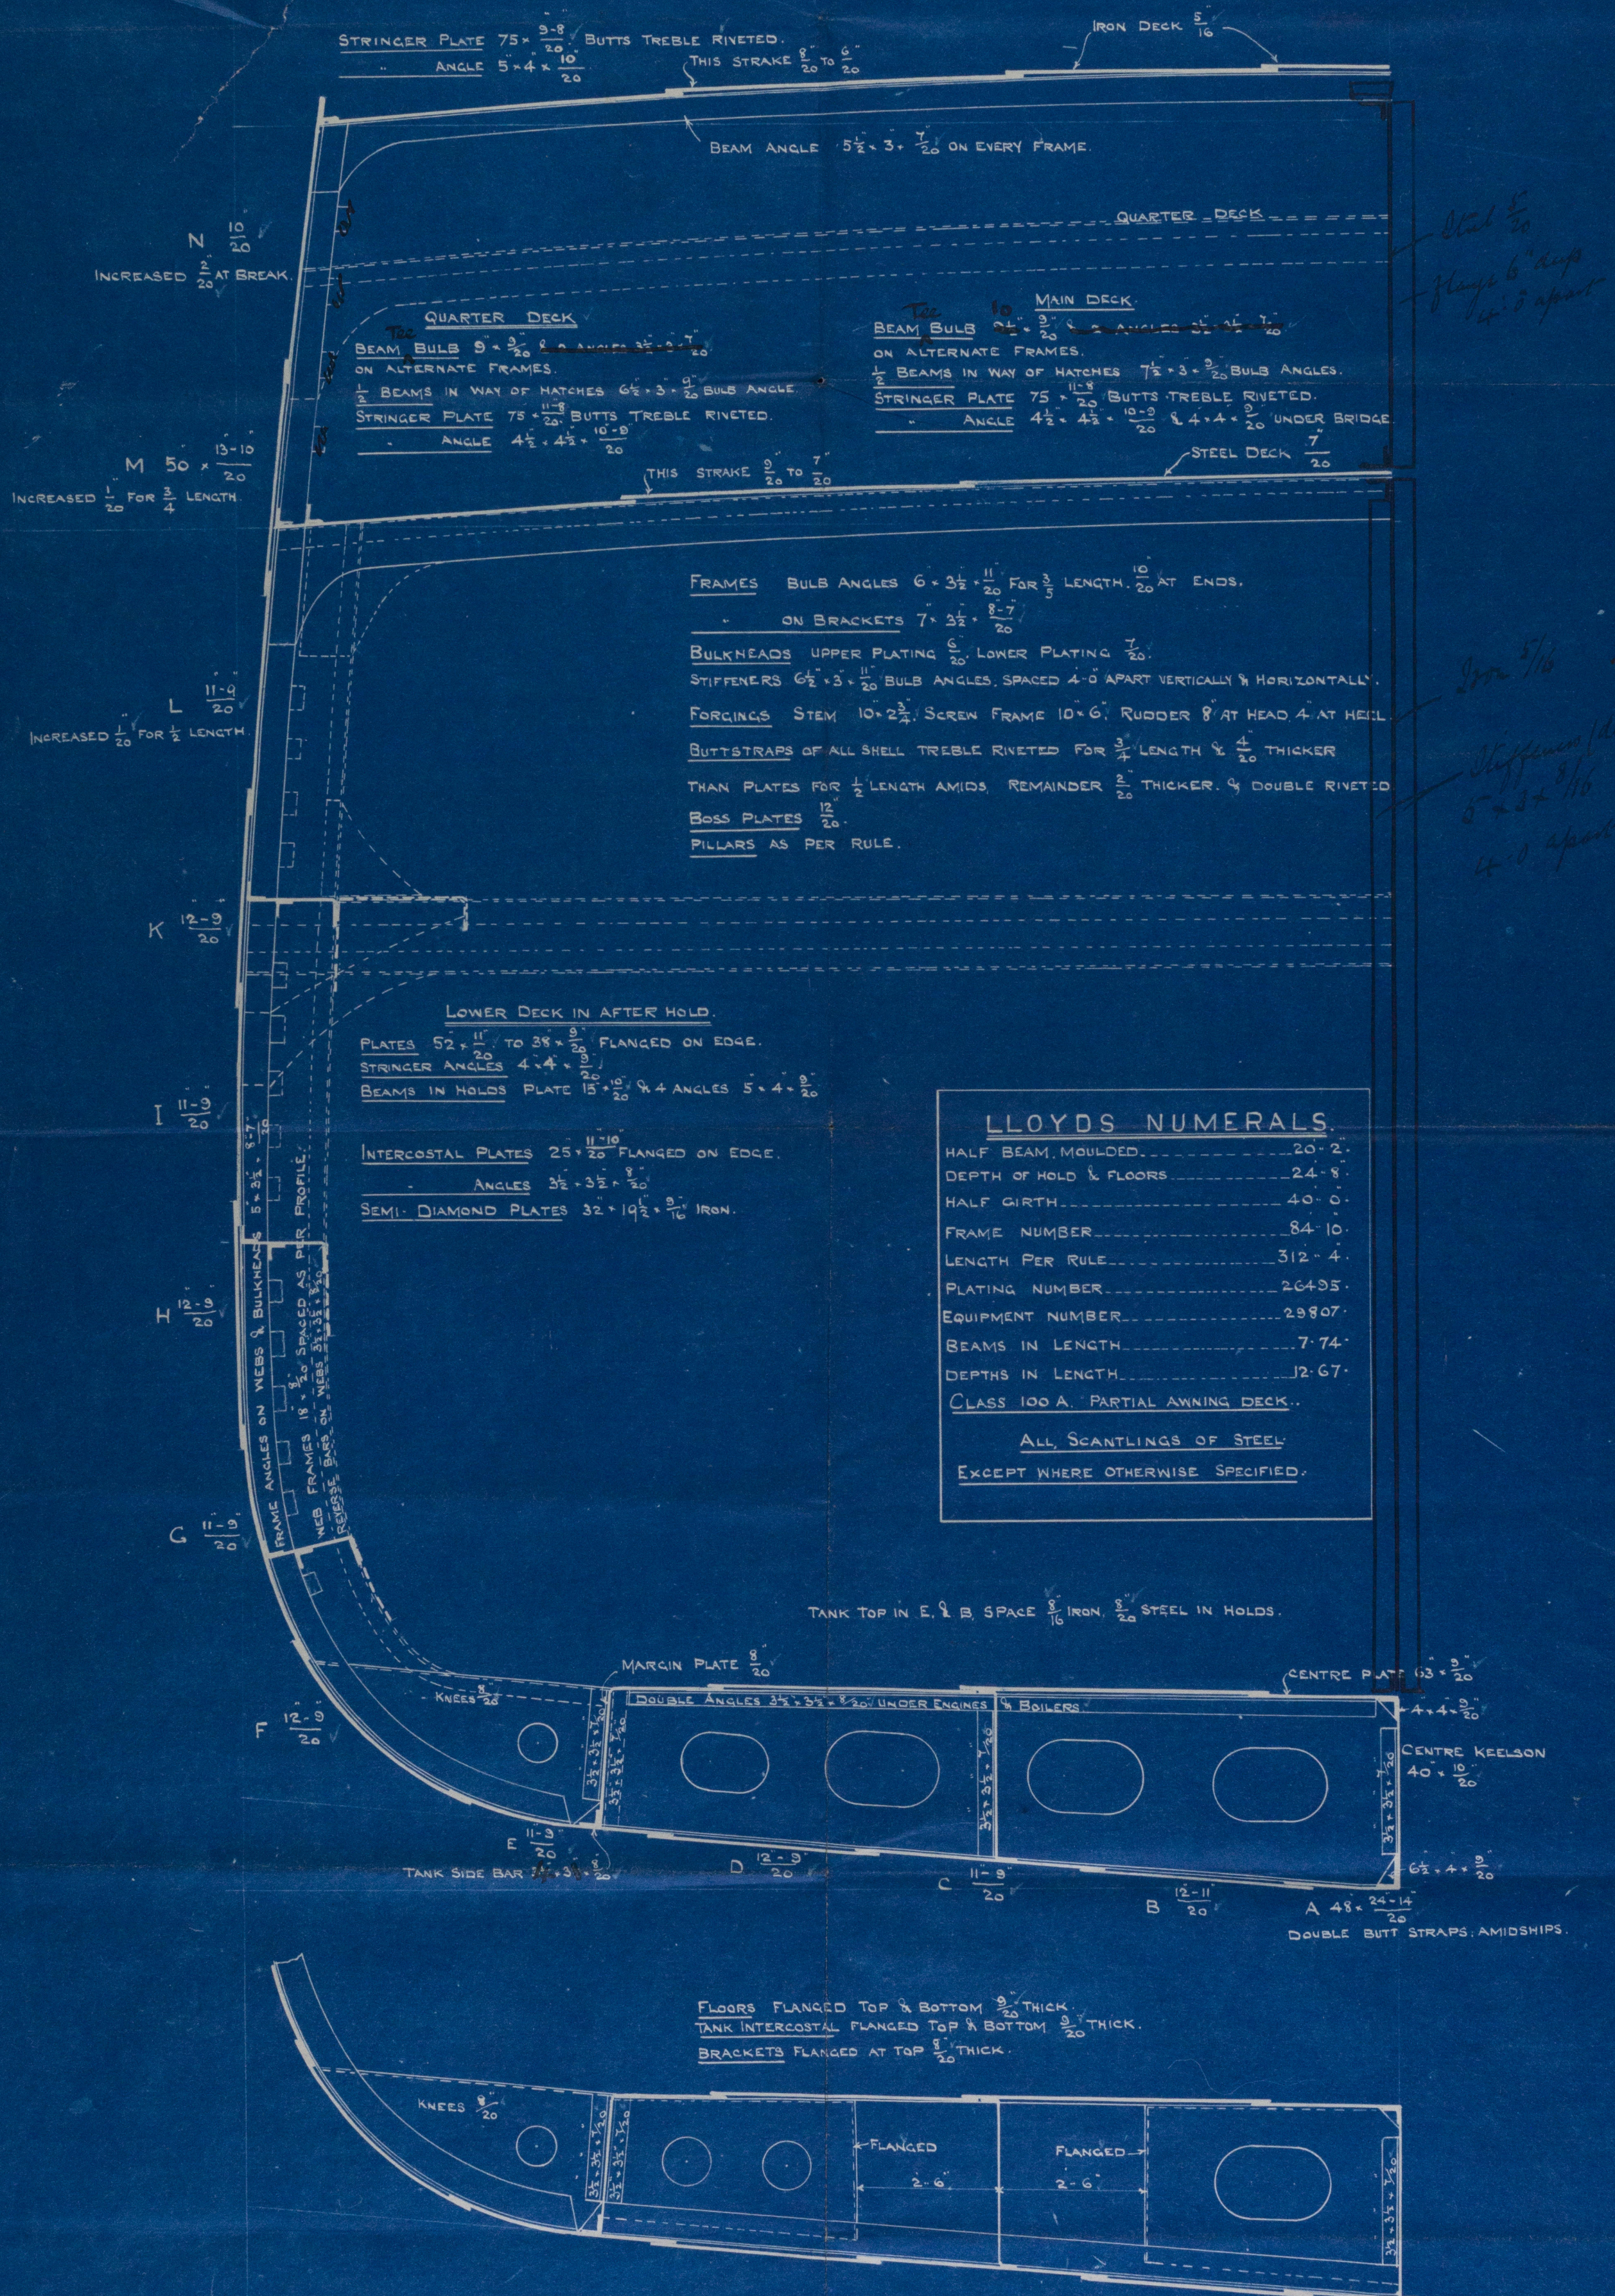

S.S. N<sup>o</sup> 198.

Supplied by approved  
 West Hartlepool  
 SHIPBUILDERS

FURNESS, WITBY & CO., LIMITED  
 SHIPBUILDERS & SHIPOWNERS,  
 WEST HARTLEPOOL.

TRACING N<sup>o</sup> 11259.  
 FEBRUARY 26<sup>th</sup> 1933.

14643



Furness Weekly No.  
No. 198.

Midship Section.

S.S. "Bellisloe",  
W. Hpl. Report No.



Copy.

MPL370 -0071



© 2019

Lloyd's Register  
Foundation