

A. S. Belkloc

Received at **WEST HARTLEPOOL** Office, *16th May* 1893

Lloyd's Register of British and Foreign Shipping.

(Report on Vessel No. *9122* Port **WEST HARTLEPOOL**.)

Wpool

No. *2458.a*

SHIP FORGINGS OR CASTINGS.

I have to report that the undermentioned Iron or Steel Forgings or Castings, manufactured by *Messrs J Richardson Sons Northport* of *Northport* for the Vessel No. *198*, being built by *Messrs Furness Withy & Co* of *Northport* have been inspected by me as set forth below, and found to be, so far as can be seen, *sound*.

Mark on Forgings.

Lloyd's

No. *2458.a*


W. Co.

Wm Cameron

Sunderland
15.5.93

	STERN FRAME.	RUDDER FRAME.	STEM.
Material*	<i>Scrap iron</i>	<i>Scrap iron</i>	<i>Scrap iron</i>
How made	<i>Forged</i>	<i>Forged</i>	<i>Forged</i>
Dimensions	<i>10' x 6"</i>	<i>8' x 16"</i>	<i>10' x 2 3/4"</i>
Progress on Inspection	<i>Forged & Smithed</i>	<i>Forged & Smithed</i>	<i>Forged</i>
Date when Inspected	<i>June 20th to July 3/93</i>	<i>July 20th to April 20/92</i>	<i>July 13/93</i>

SKETCHES OF FRAMES SHOWING POSITION AND DESCRIPTION OF WELDS OF FORGINGS, OR PARTICULARS OF TESTS APPLIED TO CASTINGS.

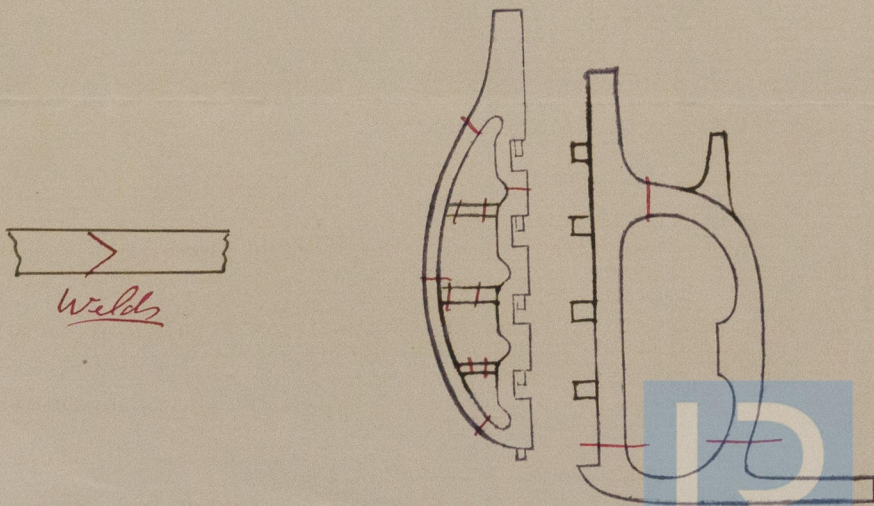

© 2019

Lloyd's Register
Foundation