

Chr. 18/2/93

No 461 SS. PUMPING ARRANGEMENT.


ENGINES No 152


UNDER DECK TONNAGE ABOUT 1800 TONS.

ALL SLUICES & HAND PUMPS WORKED FROM DECK.
SLUICES TO BE AT ALL TIMES ACCESSIBLE.

ENGINE & BOILER
SPACE.

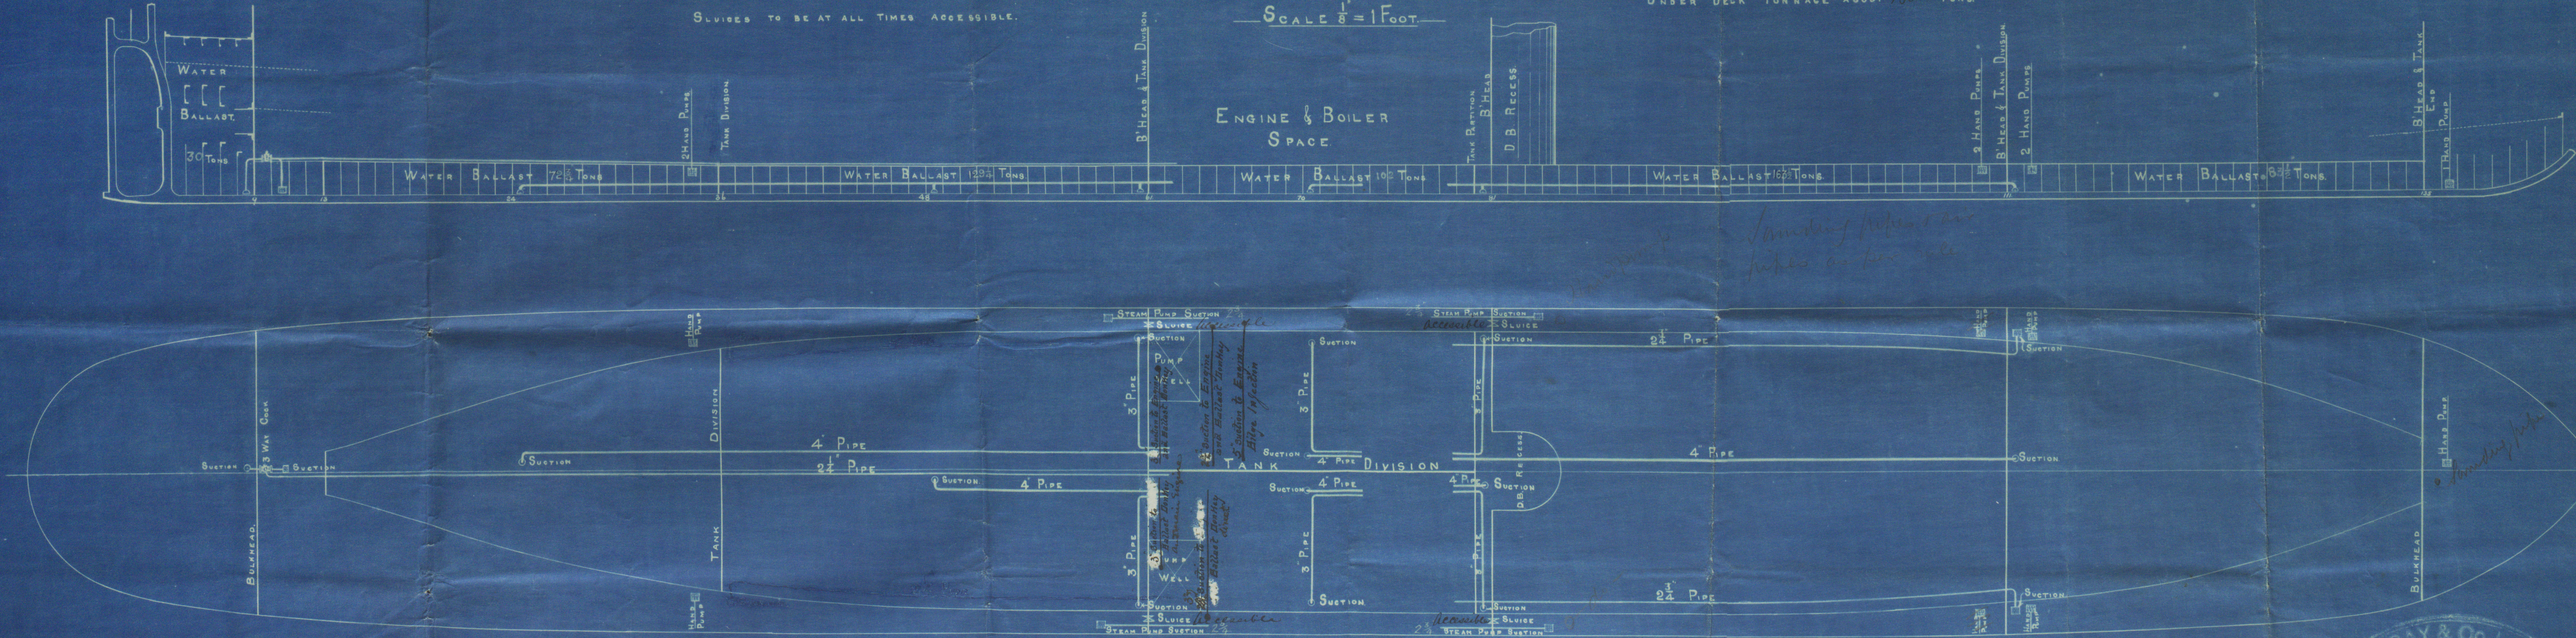

461

1/11/93



461
R

Pumping Plan
Wharfedale
Hessel N° 461

Central Marine Eng Works
Engines N° 15-2
8.2.93

S.A. Adjutant,
W. H. Report N° 9128.



HPL376-0080



© 2019



Register
Foundation