

sketch
after patent, same as
100 + 0.05, p. 1. 0.01


SKETCH of IRON LOWERMASTS

Messrs FURNESS, WITHY'S No 199 VESSEL

SCALE $\frac{1}{4}$ " = ONE FOOT

& also 200 and 201 Vessels
To carry fore & aft sail only

Masts made in two plates in the round
Butts below deck double, above dk treble riveted, all $\frac{1}{16}$ thicker than plates
Seams single riveted.

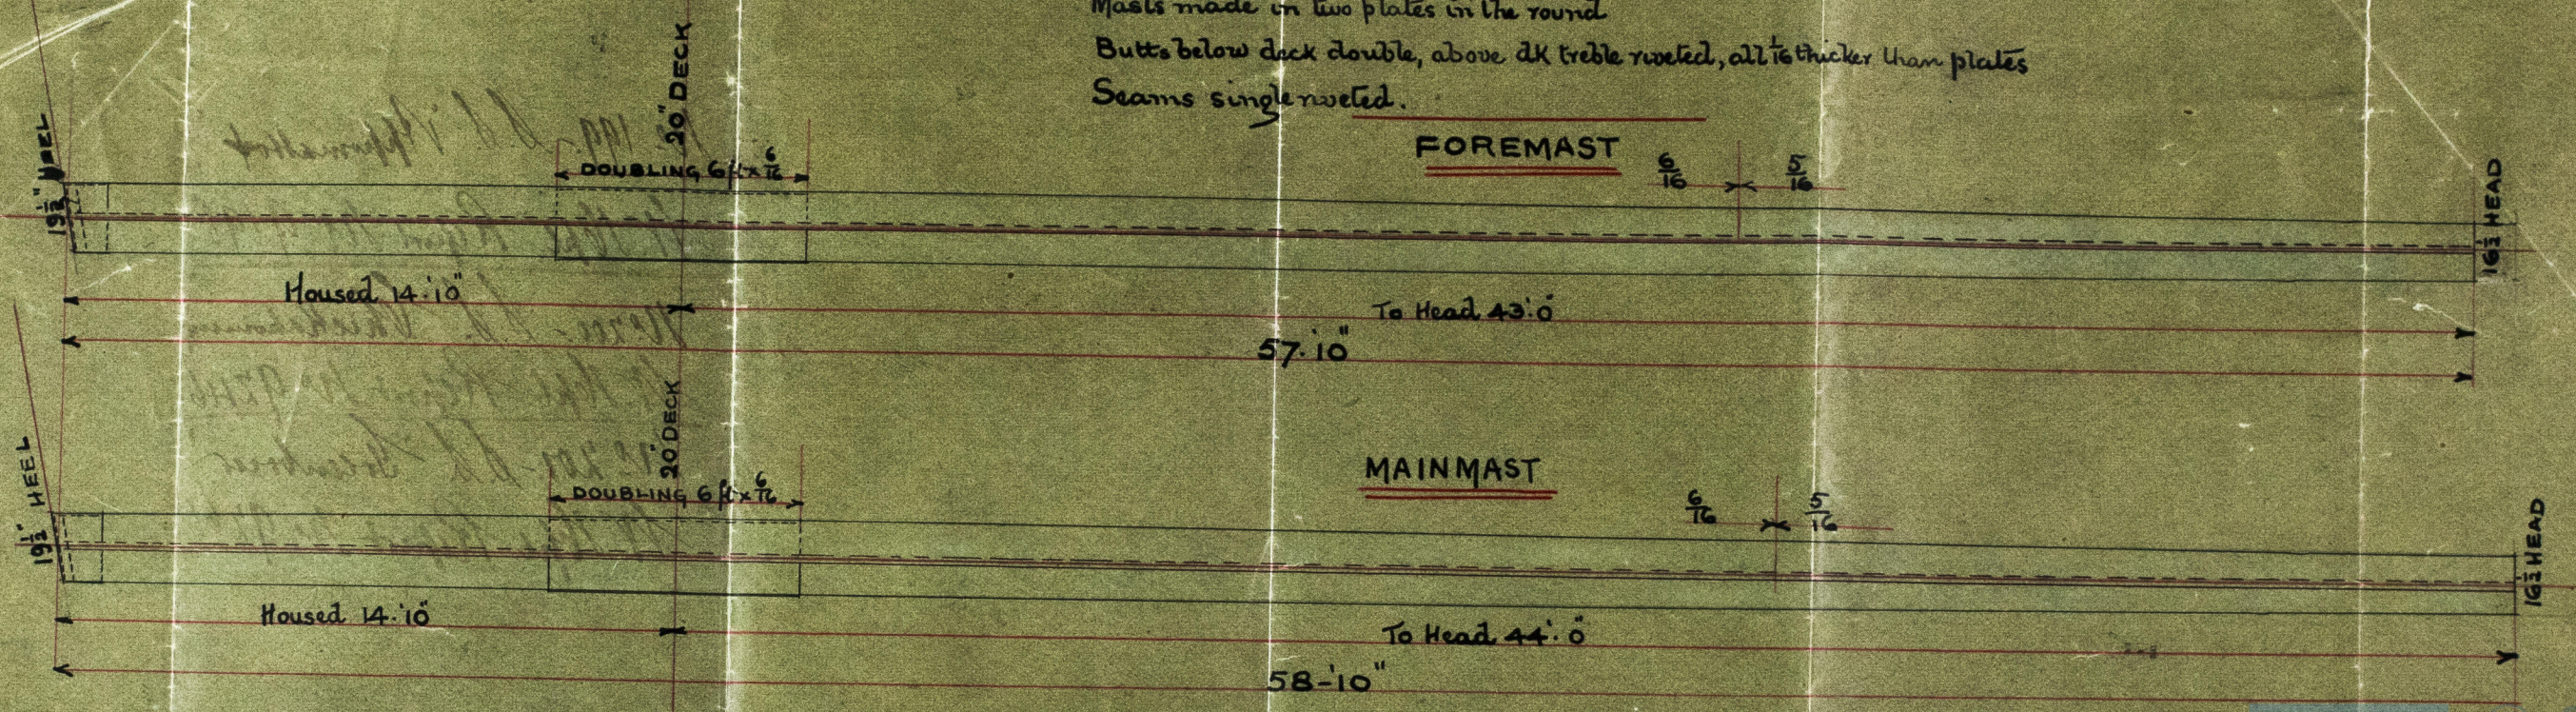

HPL371-0023

Maats

Furness, Kitty r/c

No. 199, 200 + 201



No. 199 - S.S. 'Appomattox'

W. Hpl. Report No. 9198

No. 200 - S.S. 'Chickahominy'

W. Hpl. Report No. 92146

No. 201 - S.S. 'Greenbrier'

W. Hpl. Report No. 9266



© 2019

Lloyd's Register
Foundation

HP2371-0023