

Lloyd's Register of British and Foreign Shipping.

(Report on Vessel No. 9198 Port WEST HARTLEPOOL.)

Wpool
No. 2478a.

SHIP FORGINGS OR CASTINGS.

I have to report that the undermentioned Iron or Steel Forgings or Castings, manufactured by Messrs Gray & Co. of Wartlepool for the Vessel No. 199, being built by Messrs Furness Withy & Co. of Wartlepool have been inspected by me as set forth below, and found to be, so far as can be seen, sound.

Mark on Forgings.

Lloyd's


No. 2478a
H.C.

Wm. Cameron

London
24.6.93

	STERN FRAME.	RUDDER FRAME.	STEM.
Material*	<u>Scrap iron</u>	<u>Scrap iron</u>	<u>Scrap iron</u>
How made	<u>Forged</u>	<u>Forged</u>	<u>Forged</u>
Dimensions	<u>11" x 6 1/2"</u>	<u>8 1/2" - 4"</u>	<u>11" x 2 3/4"</u>
Progress on Inspection	<u>Forged & smoothed</u>	<u>Forged & smoothed</u>	<u>Forged</u>
Date when Inspected	<u>July 29th & March 14/93</u>	<u>April 18th & June 14/93</u>	<u>July 22/93</u>

SKETCHES OF FRAMES SHOWING POSITION AND DESCRIPTION OF WELDS OF FORGINGS, OR PARTICULARS OF TESTS APPLIED TO CASTINGS.

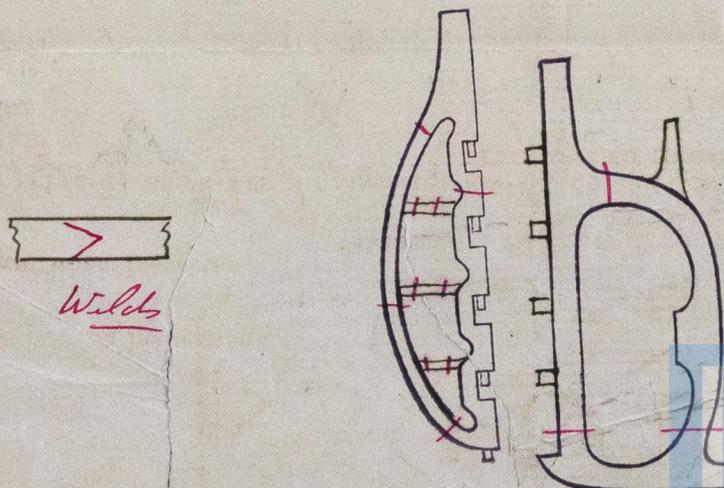

© 2019

Lloyd's Register
HPL371-0024
Foundation