

Furness Withy & Co.

Nos. 199, 200, 201

Friendship Section



No 199. S.S. 'Appomattox'  
W. Hpl. Report No. 9198

No 200. S.S. 'Chickahominy'  
W. Hpl. Report No. 9209  
No 1st Entry No. 92146


No 201. S.S. 'Greenbrier'  
W. Hpl. Report No.

HPL371-0026



# MIDSHIP SECTION

SCALE  $\frac{1}{2}$  = 1 FOOT.

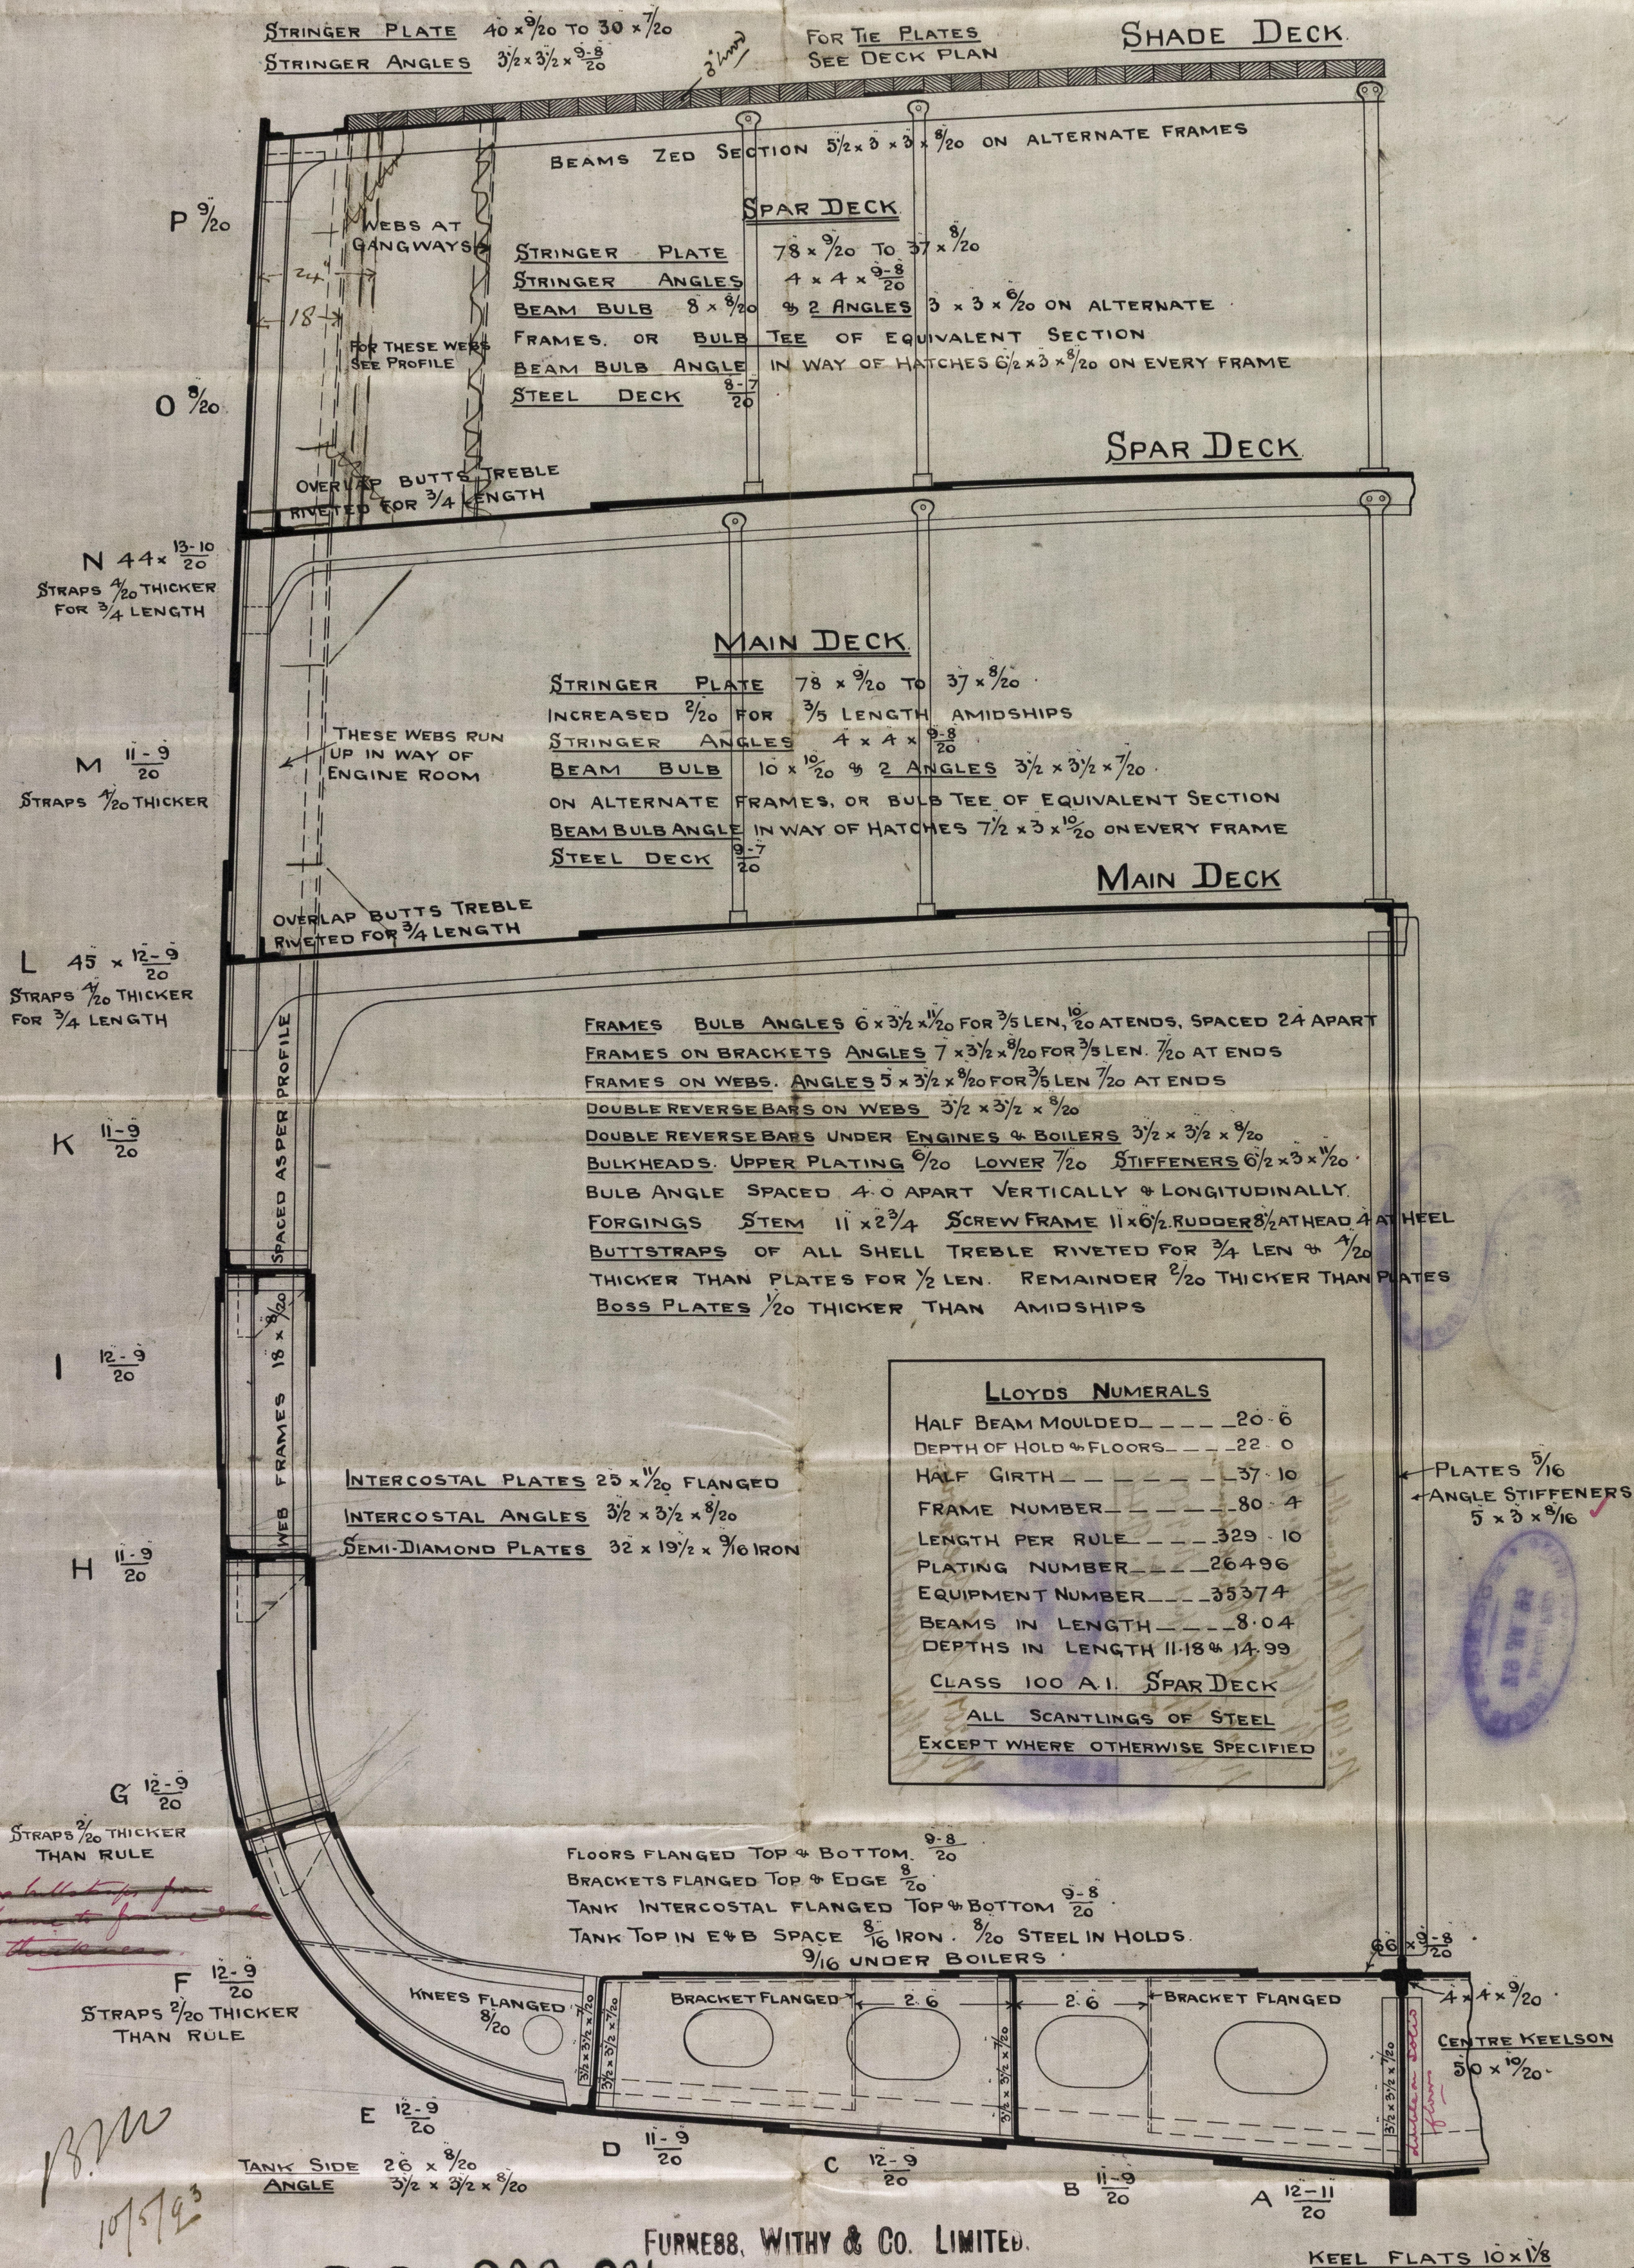

FURNESS, WITBY & CO. LIMITED.

N<sup>o</sup> 199, 200 & 201

SHIPBUILDERS & SHIPOWNERS,  
 WEST HARTLEPOOL.  
 MAY 5<sup>th</sup> 1893



Lloyd's Register  
 Foundation  
 HPL371-0026