


gangway doors.  
 Furness Withy & Co.  
No. 199, 200, 201

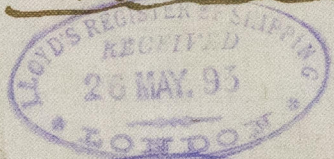

No. 199. S.S. "Appomattox",  
 W. Mpl. Report No. 9198.

No. 200. S.S. "Chickahominy",  
 W. Mpl. Report No. 9246

No. 201. S.S. "Greenbrier",  
 W. Mpl. Report No. 9266

HPL371-0027











N<sup>o</sup> 199  
SCALE 1/2" = 1 FOOT

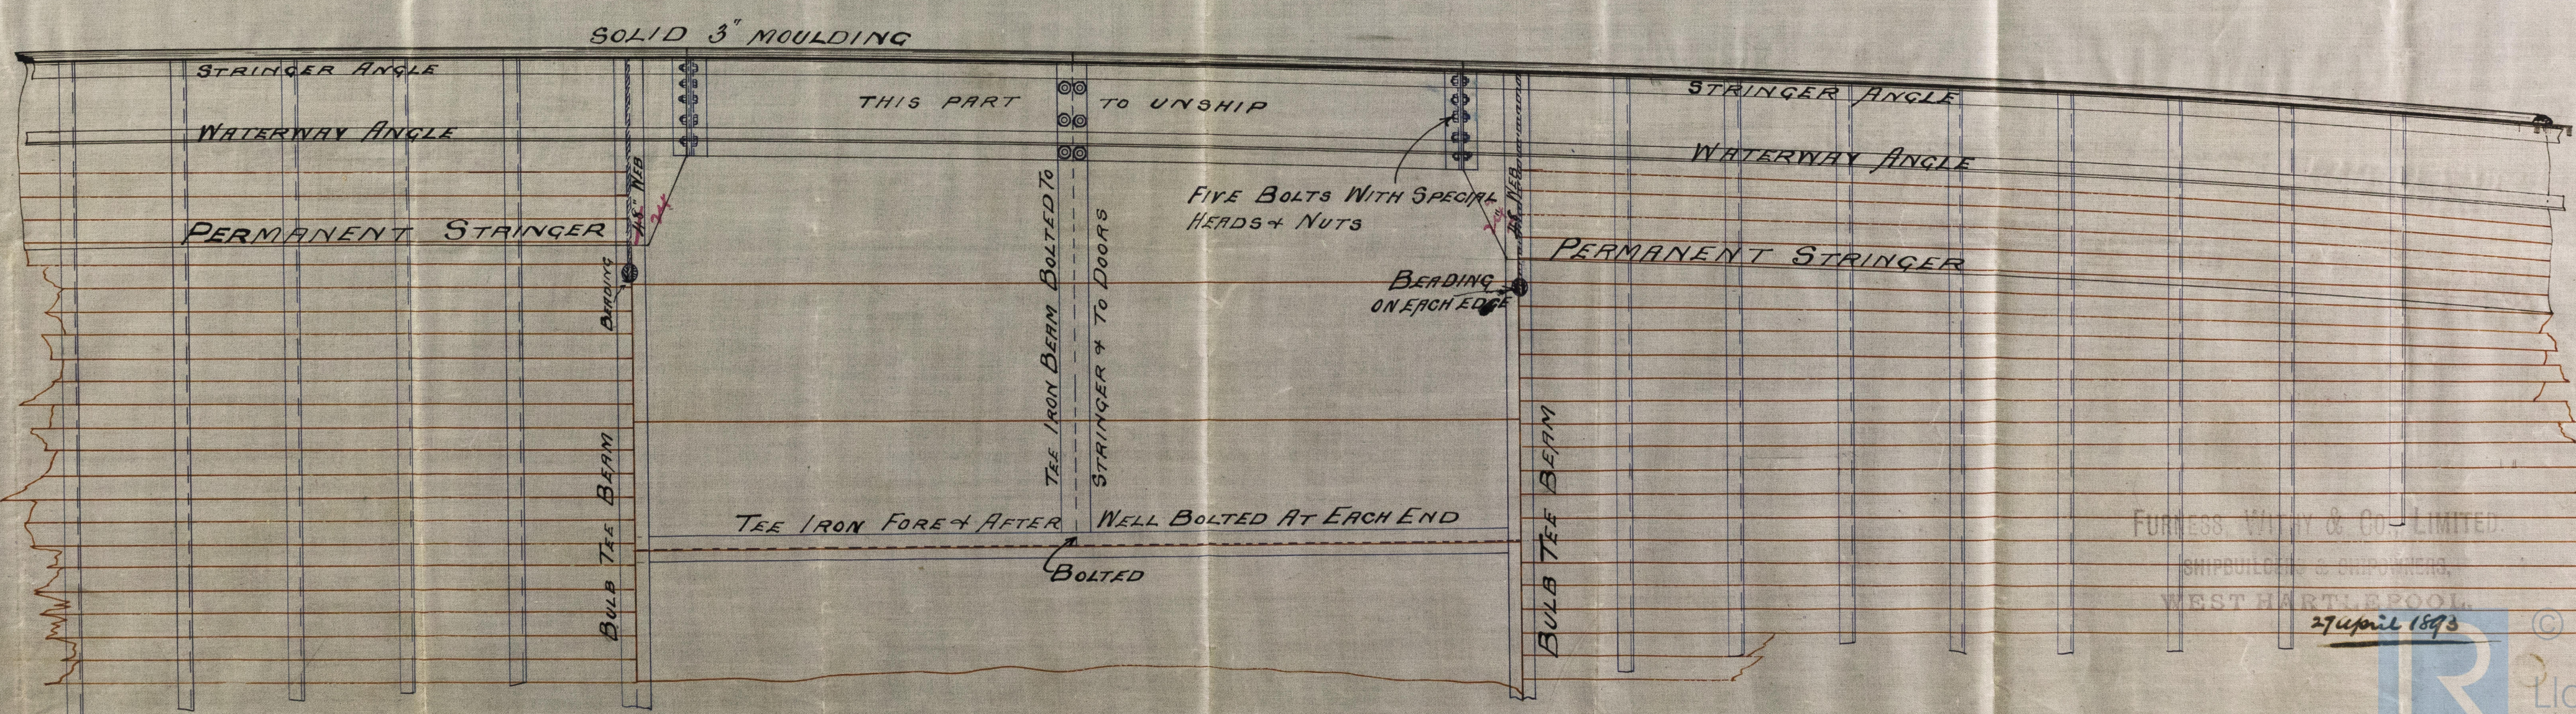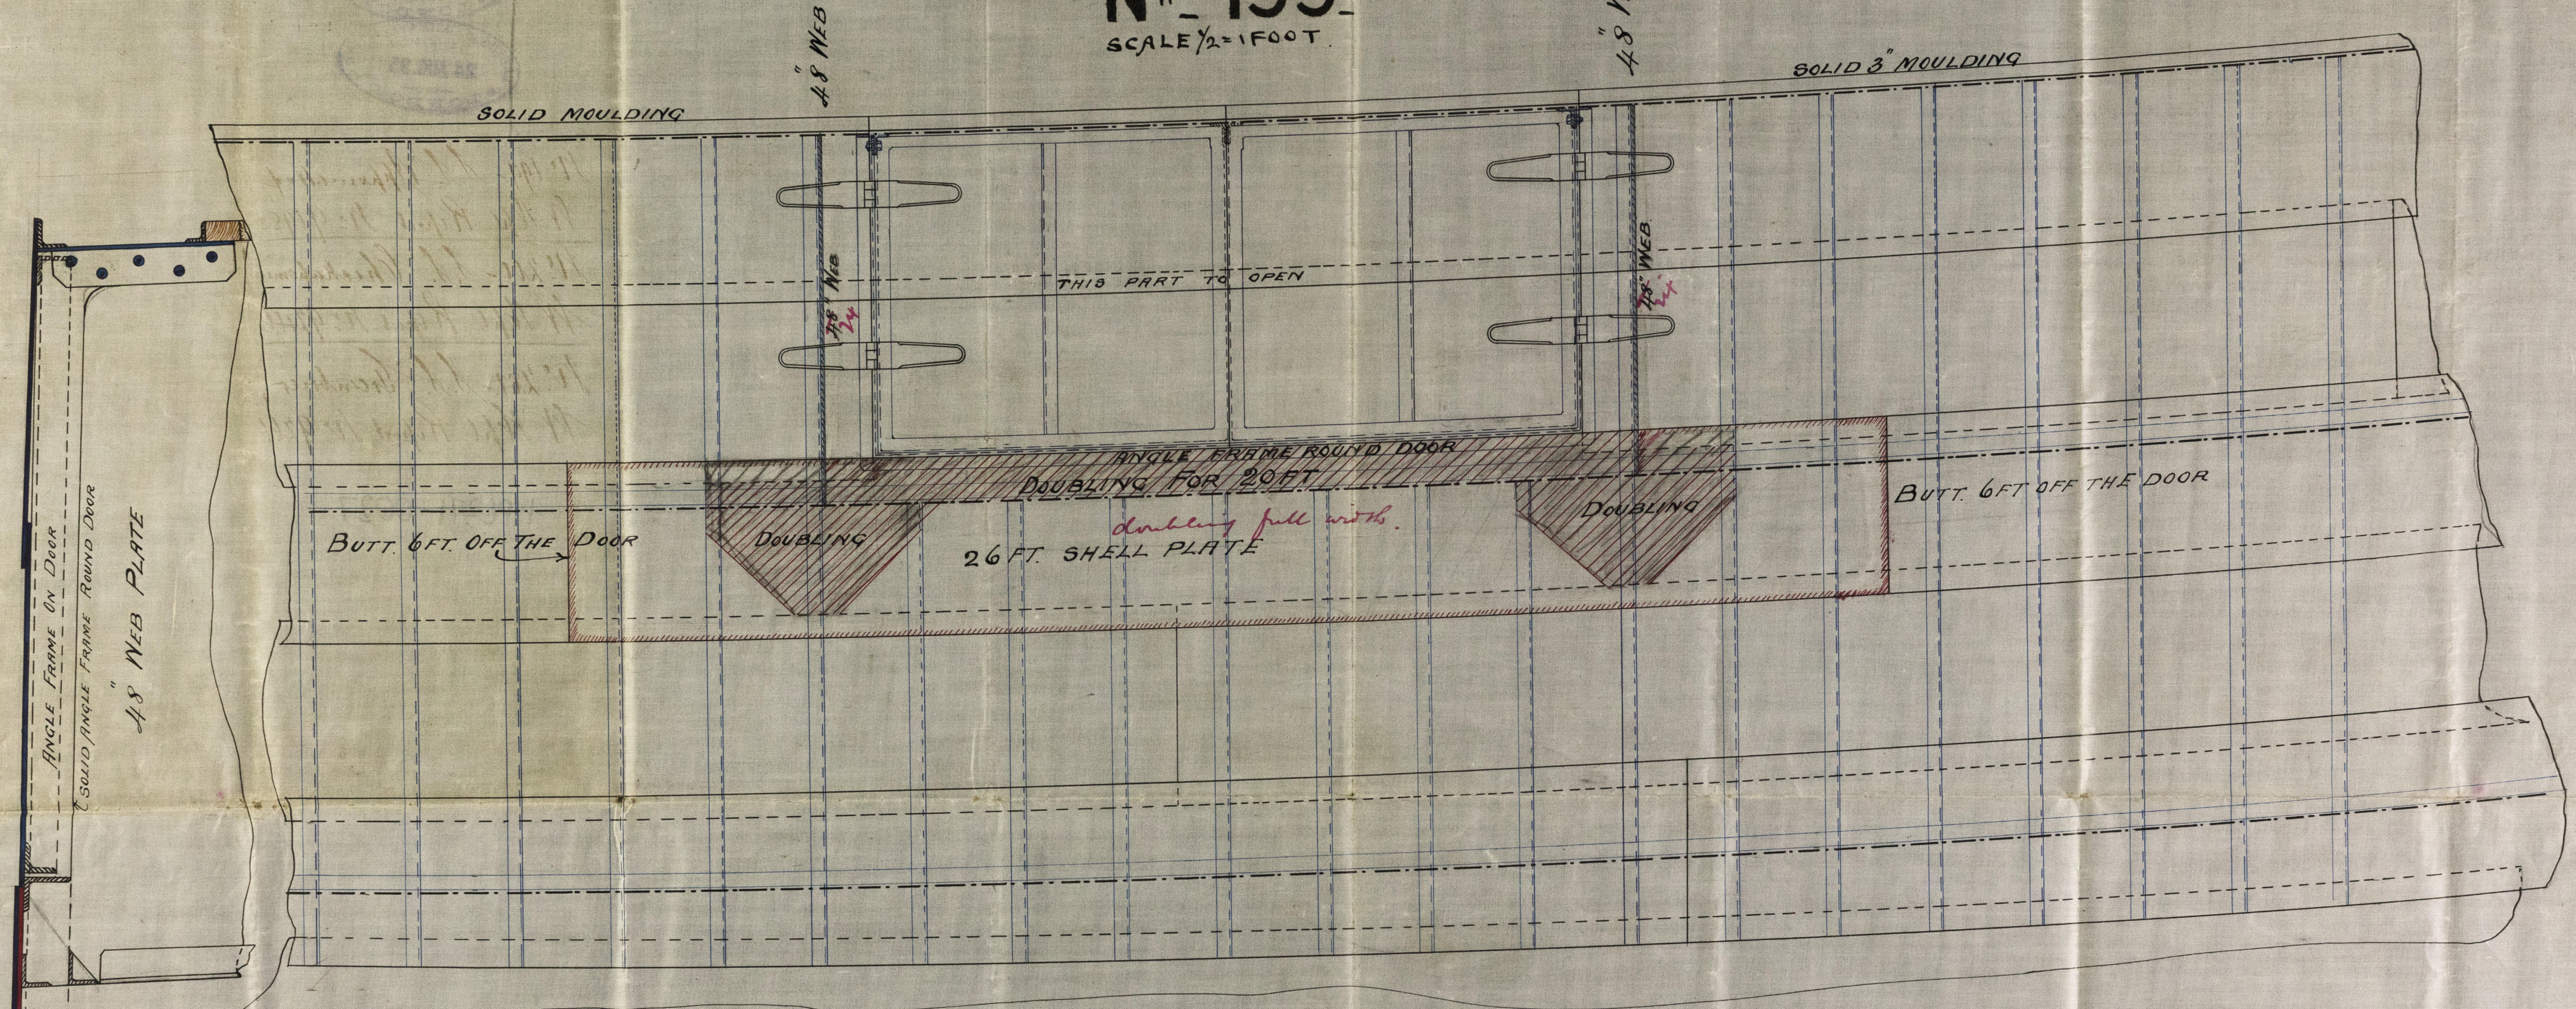

*1870  
10/5/93*

FURNESS WILBY & CO. LIMITED.  
SHIPBUILDERS & SHIPREPAIRERS,  
WEST HARTLEPOOL.

27 April 1893