


No 199

Thomas Writting & Co.
Nos. 199, 200, 201
Upside plating




10/10/93
3/10/93

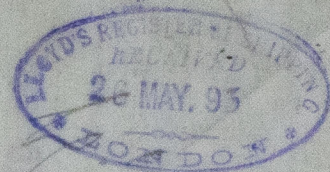

N^o 199

No. 199.- S.S. Appomattox,
W. Wpt. Report No. 9198
W. Wpt. Report No. 9246
No. 201.- S.S. Greenbriar,
W. Wpt. Report No. 9266

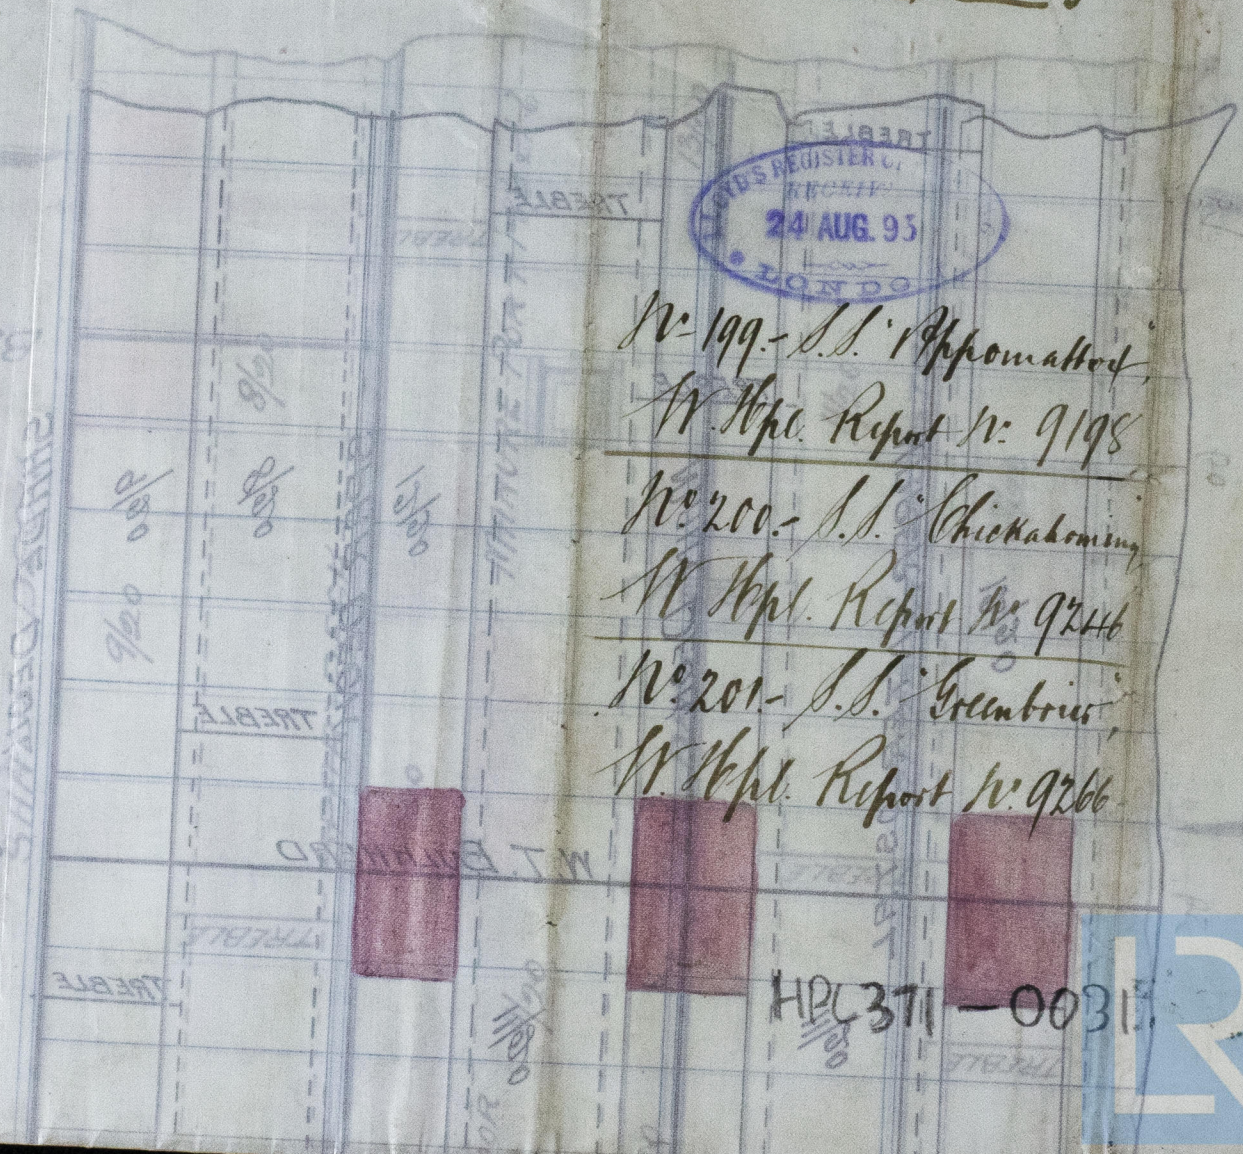

HPL371-0031



© 2020

Lloyd's Register
Foundation