

H. Greenbois

The words FORGINGS or CASTINGS, IRON or STEEL, should be struck out as may be required.

Lloyd's Register of British and Foreign Shipping.

W pool (Report on Vessel No. *9266* Port WEST HARTLEPOOL.)

No. 2511.a. SHIP FORGINGS OR CASTINGS.

I have to report that the undermentioned Iron ~~or Steel~~ Forgings ~~or Castings~~,
 manufactured by *Messrs J Richardson Sons*
 of *Wartlepool* for the Vessel No. *201*, being built
 by *Messrs Furness Withy & Co* of *Wartlepool*
 have been inspected by me as set forth below, and found to be, so far as can be seen,
sound.

Mark on Forgings.


Lloyd's
 No. 2511a
 W.C.

Rough Cannon

Sunderland
9. 10. 93

	STERN FRAME.	RUDDER FRAME.	STEM.
Material*	<i>Scrap iron</i>	<i>Scrap iron</i>	<i>Scrap iron</i>
How made	<i>Forged</i>	<i>Forged</i>	<i>Forged</i>
Dimensions	<i>11" x 6 1/2"</i>	<i>8 1/2" - 4"</i>	<i>11" x 2 3/4"</i>
Progress on Inspection	<i>Forged & smithed</i>	<i>Forged & smithed</i>	<i>Forged</i>
Date when Inspected	<i>April 8th to June 19/93</i>	<i>July 3rd to Sept 18/93</i>	<i>June 19/93</i>

SKETCHES OF FRAMES SHOWING POSITION AND DESCRIPTION OF WELDS OF FORGINGS, OR PARTICULARS OF TESTS APPLIED TO CASTINGS.

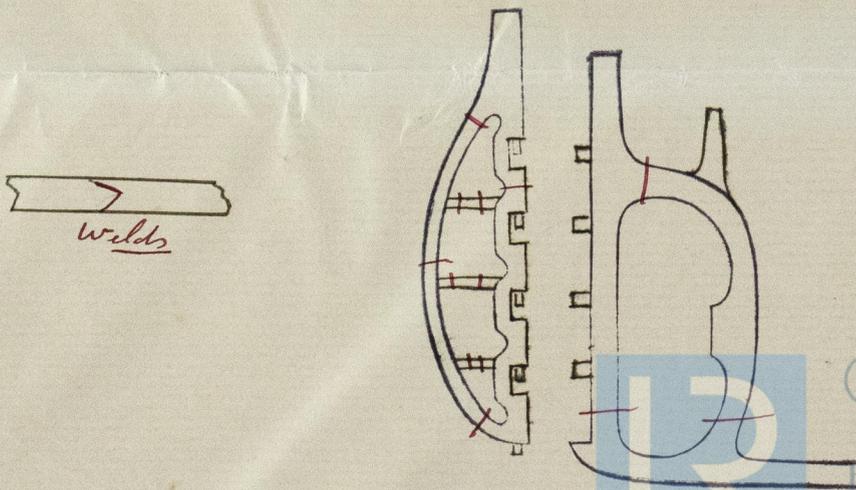

© 2019

Lloyd's Register Foundation

HPL371-0147

2571