

S.S. Pacific

WEST HARTLEPOOL.

Received at

Office.

26th October 1893

Lloyd's Register of British and Foreign Shipping.

Westpool

(Report on Vessel No. *9291* Port WEST HARTLEPOOL.)

No. *2585-a*. SHIP FORGINGS OR CASTINGS.

The words FORGINGS or CASTINGS, IRON or STEEL, should be struck out as may be required.

I have to report that the undermentioned Iron ~~or Steel~~ Forgings ~~or Castings~~, manufactured by *Mp & Gray Co.* of *Wentworth* for the Vessel No. *469*, being built by *Mp & Gray Co.* of *Wentworth* ^{*in Glasgow*} have been inspected by me as set forth below, and found to be, so far as can be seen, *sound.*

Mark on Forgings.

Lloyd's

No. *2585-a*


No. 6.

Wm Cameron
Sunderland.

L.S. 10. 93

	STERN FRAME.	RUDDER FRAME.	STEM.
Material* ...	<i>Scrap iron</i>	<i>Scrap iron</i>	<i>Scrap iron</i>
How made ...	<i>Forged</i>	<i>Forged</i>	<i>Forged</i>
Dimensions ...	<i>10" x 6"</i>	<i>8" - 4"</i>	<i>10" x 2 5/8"</i>
Progress on Inspection	<i>Forged & smithed</i>	<i>Forged & smithed</i>	<i>Forged</i>
Date when Inspected	<i>July 2nd to Sept 1/93</i>	<i>Sept 13th to Oct 20/93</i>	<i>Sept 1/93</i>

SKETCHES OF FRAMES SHOWING POSITION AND DESCRIPTION OF WELDS OF FORGINGS, OR PARTICULARS OF TESTS APPLIED TO CASTINGS.

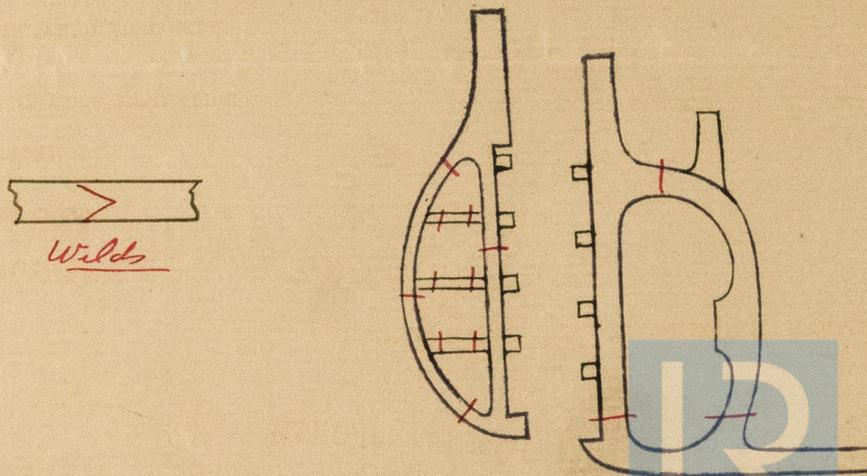

© 2019

Lloyd's Register Foundation