

Ref: 25 10:93


N^o 469 S.S.

Engine N^o 163.

ENGINE N^o 163.
UNDER DECK TONNAGE ABOUT 1950 TONS.


PUMPING ARRANGEMENT.

SCALE 1/8 INCH = 1 FOOT.

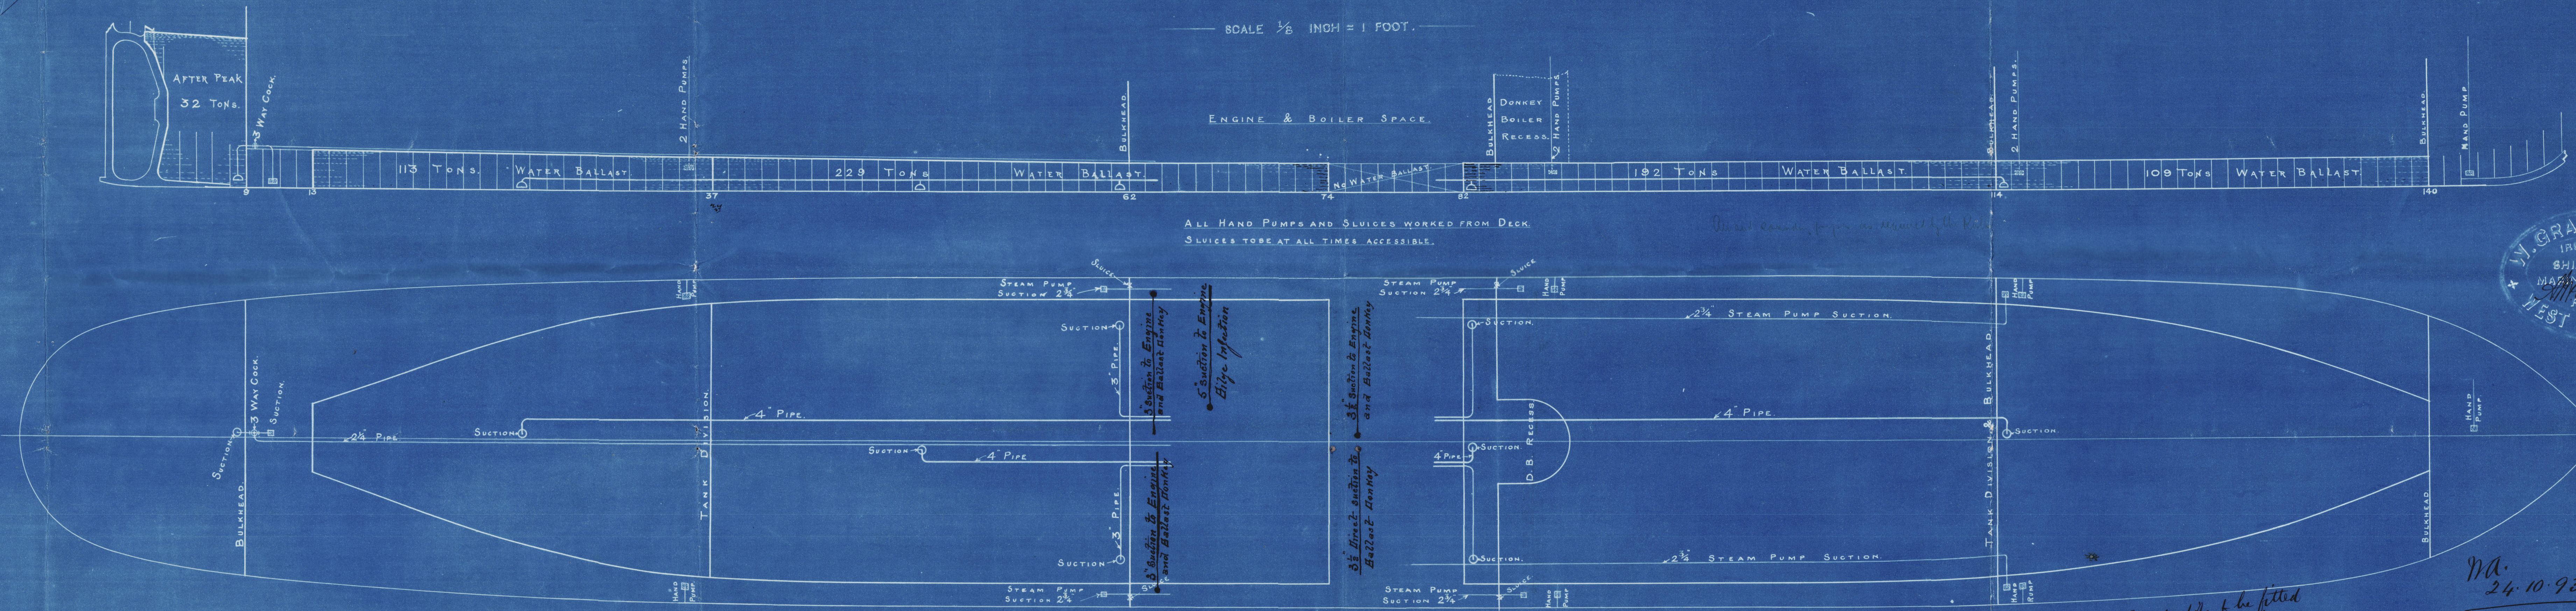

ALL HAND PUMPS AND SLUICES WORKED FROM DECK.
SLUICES TO BE AT ALL TIMES ACCESSIBLE.

Drawn according to plan as required by the Rules.

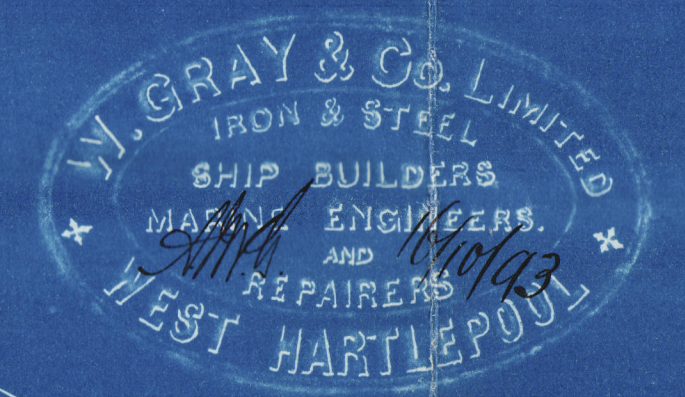

Air & sounding pipes to be fitted as required by the rules

MA.
24.10.93



To Gray & Co
469

Pumping plan

Pacific



W. Hpl. Report N: 9291

HPL 372-0011



© 2020

Lloyd's Register
Foundation