

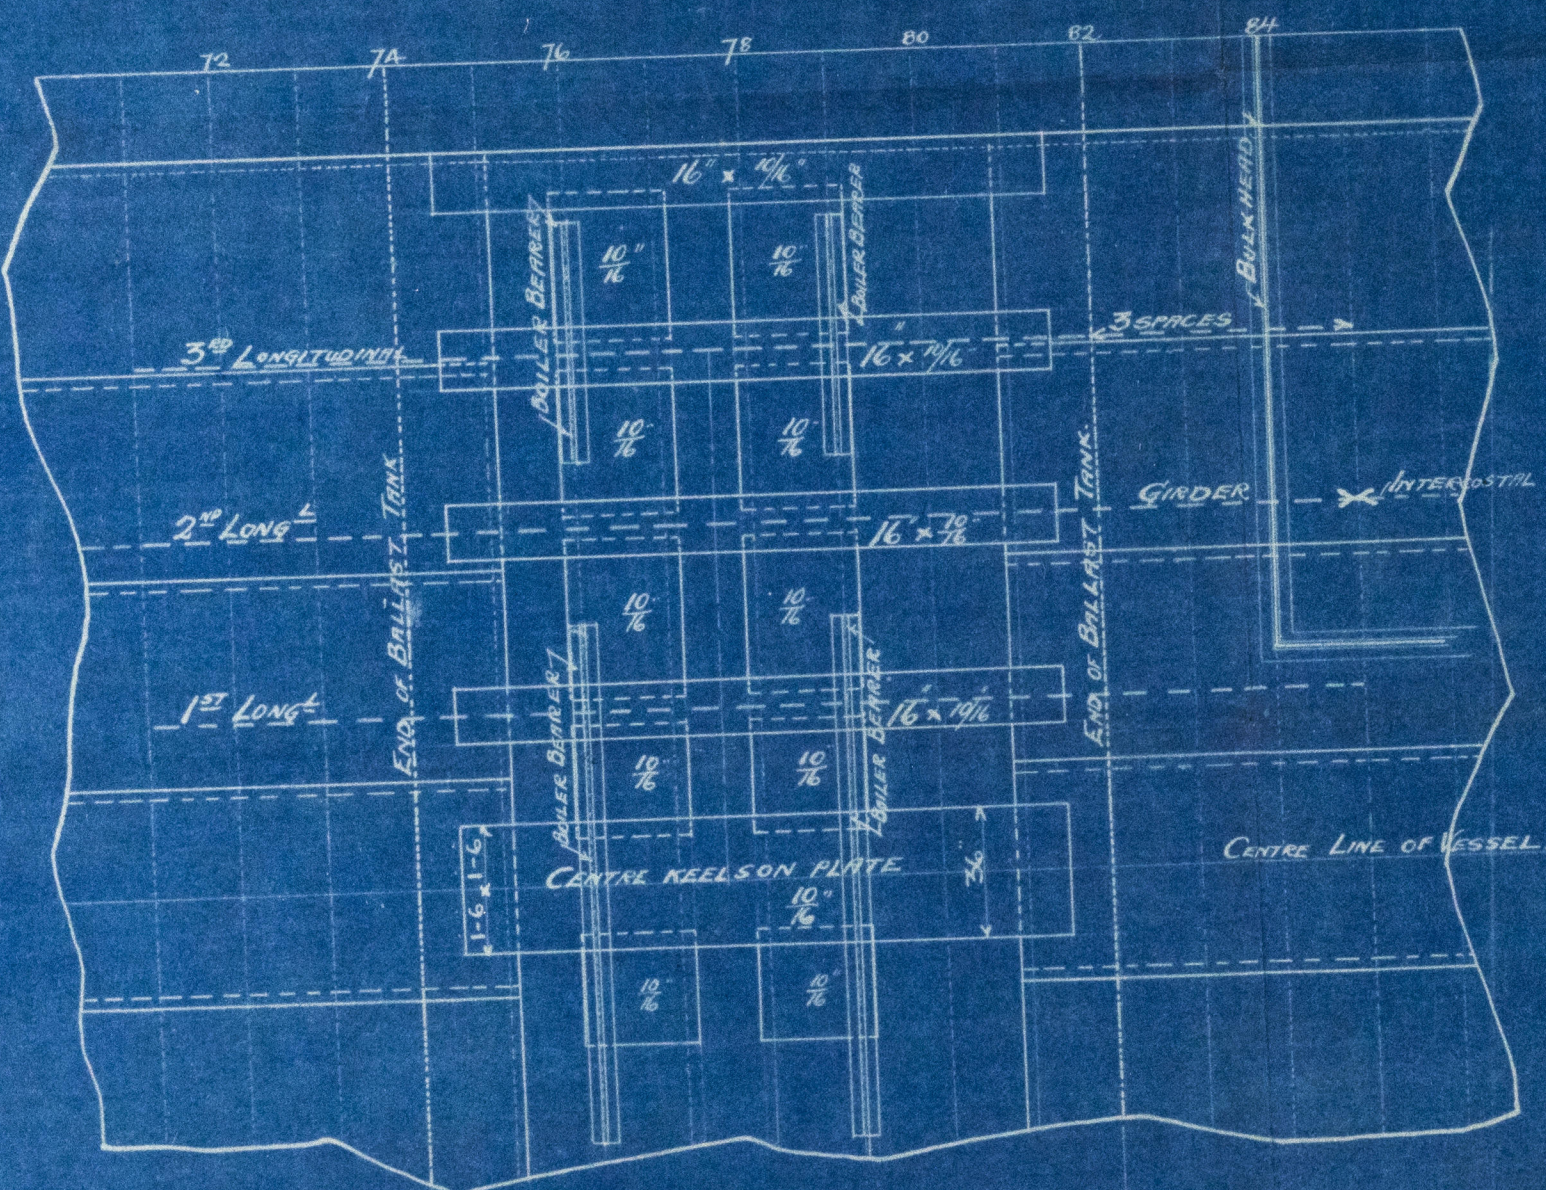
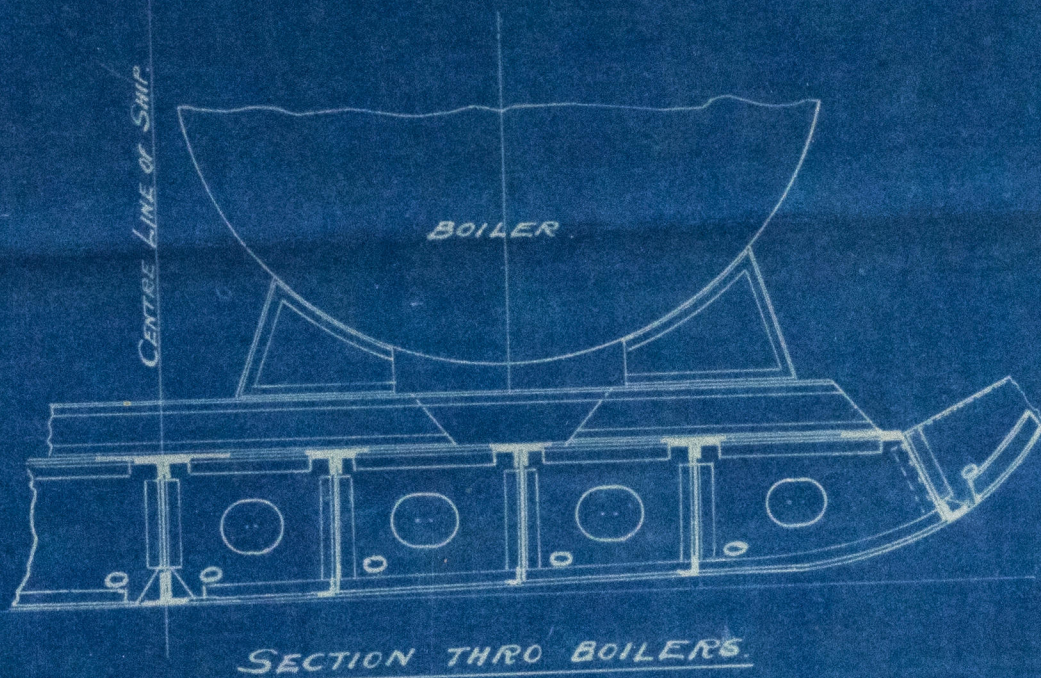


28.7.93

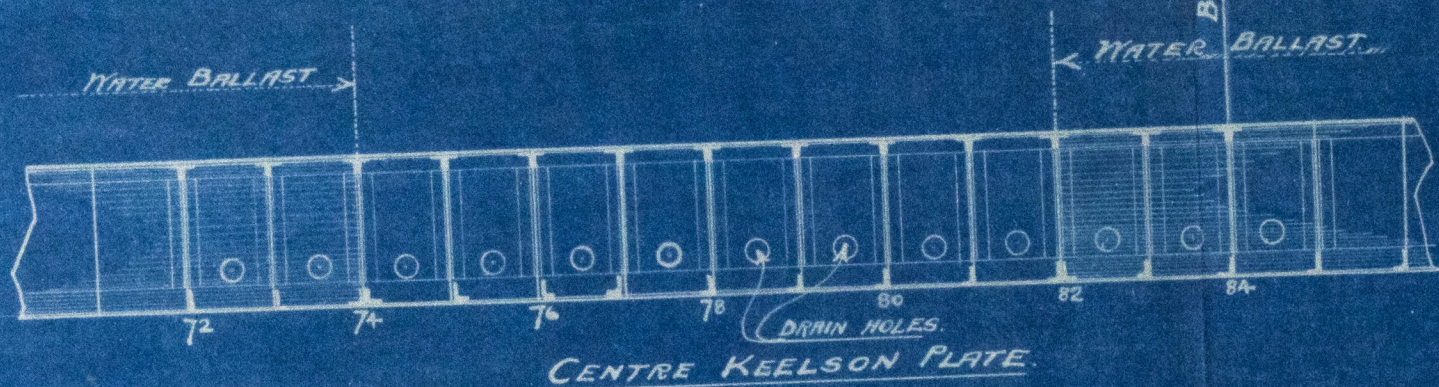

S. S. N° 469
SKETCH OF FLOORS UNDER BOILERS.
SCALE 1/4" = 1 FT

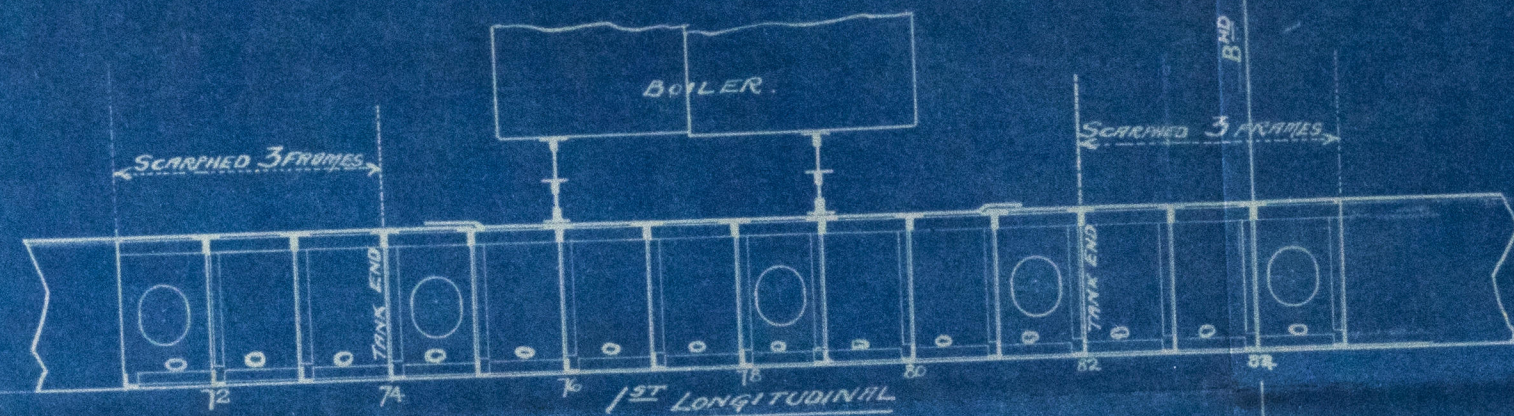

469

SHELL PLATING NOT TO BE REDUCED IN THICKNESS.

469
HPL 372-0014

H. Gray & Co^{rs}
West Hartlepool

L.S. No 469
Part Aun^y are
"Pacific"

Plan of Cellular
bottom under Boilers

Rept. No 9291 1st Entry



LR

Lloyd's Register
Foundation