

Depth from Partners to Laid top

Fore Mast 25'-6"

Main Mast 21'-0"

# SKETCH of IRON LOWERMASTS.

Fore & Aft Sails only.

FOR MESSRS FURNESS, WITHEY, & CO'S NO 202 S.S.


SCALE  $\frac{1}{4}$ " = 1 FOOT

Note: Masts made in two plates in the round, seams single riveted.


Butts in housing double riveted, remainder triple riveted. Rivets in the bands and Butts to be spaced 5 diameters apart.

Buttstraps 16 thicker than plates they connect.

## FOREMAST

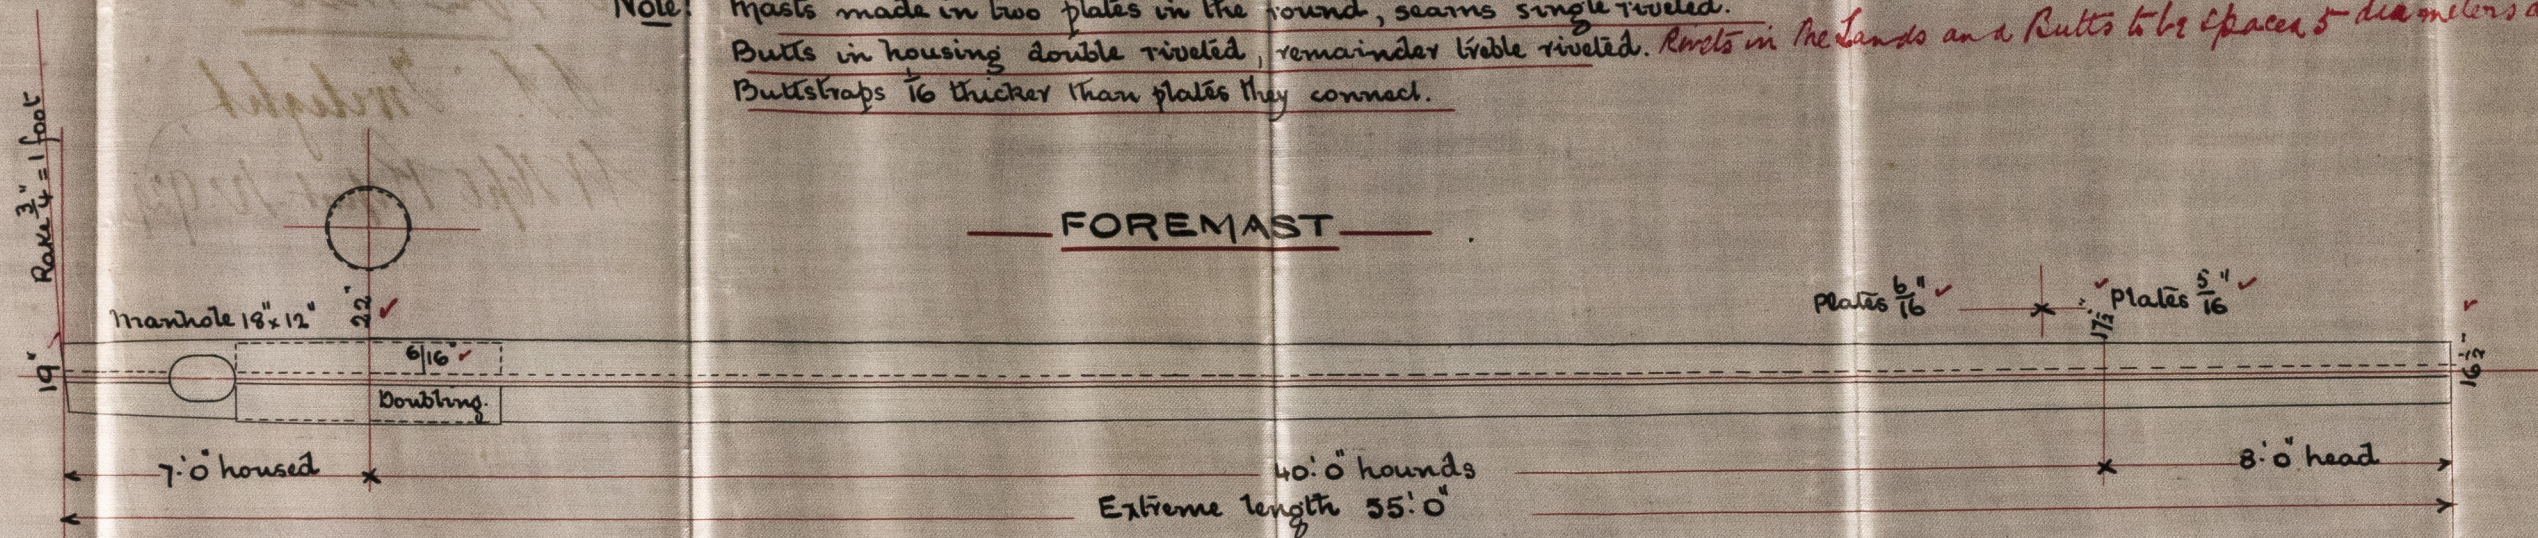

## MAINMAST

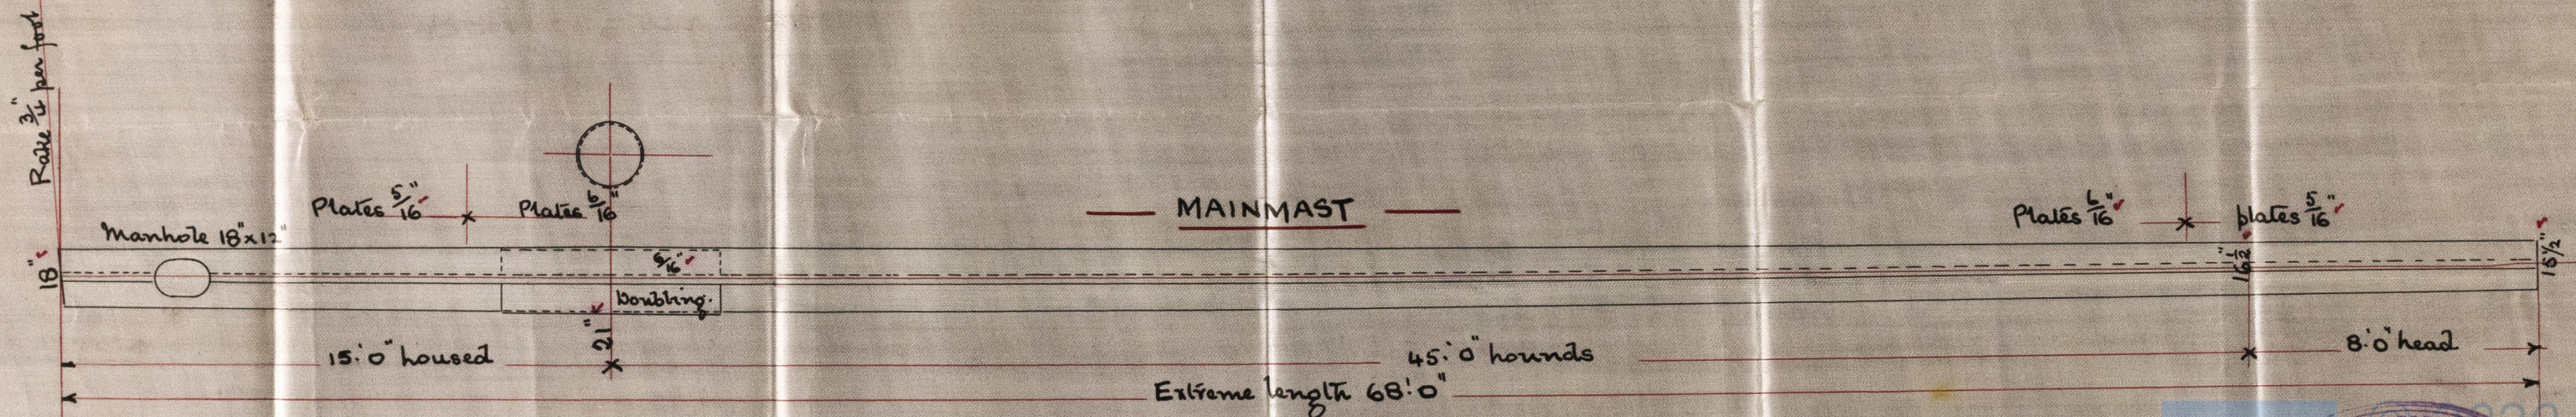

HPL372-0021



Furness Withy & Co.

No. 202

Iron Masts

S.S. "Twilight"

W. Hpl. Report N. 9298.

HPL372-0021

© 2020

Lloyd's Register  
Foundation