


Ref: 25.11.93

PUMPING ARRANGEMENT.

SCALE $\frac{1}{8} = 1$ FOOT.

Tonnage under deck estimated at 1393 tons -

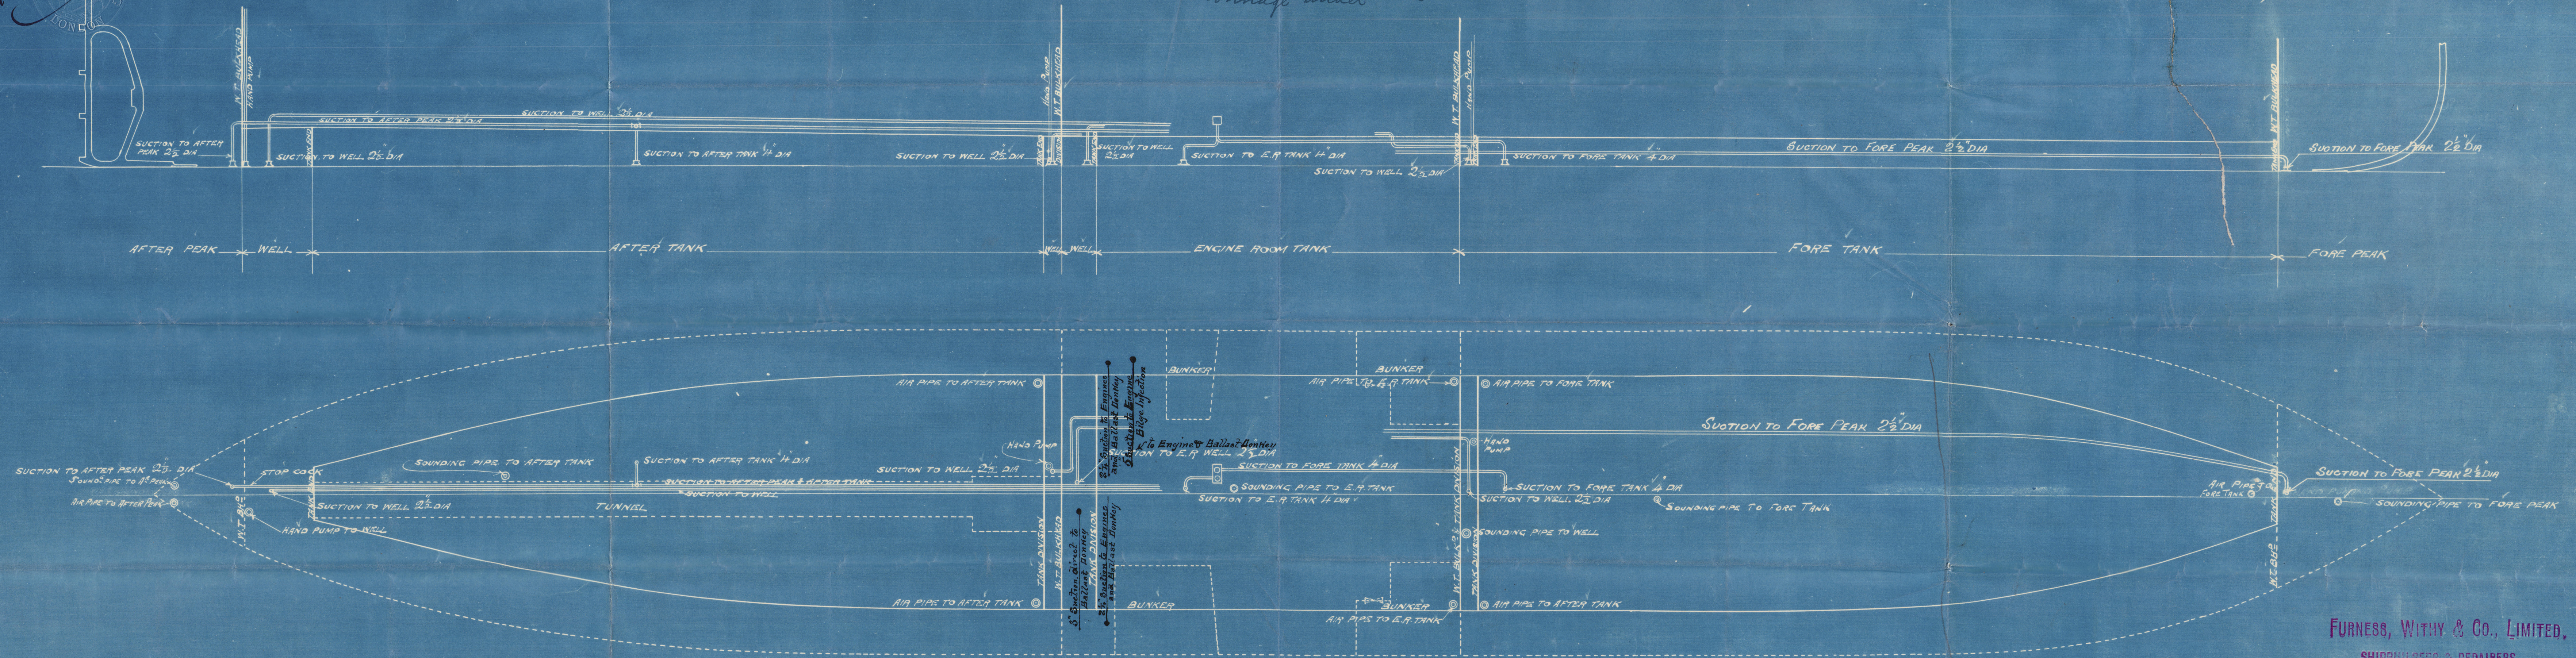

N°202

Assemble since to be fitted
 Clives omitted by Shipbuilders
 with the Owners approval C.F.

J.M.
 20/11/93

FURNESS, WITBY & Co., LIMITED,
 SHIPBUILDERS & REPAIRERS,
 WEST HARTLEPOOL,
 10th NOV 1893.

Lloyd's Register
 HPL372-60227



Furness Withy & Co.

No. 202

Pumping arrangement.

Central Marine

Engines No 165

S.S. "Twilight"
W. Hpl. Report No 9298

UPL 372-0022



© 2020

Lloyd's Register
Foundation