


# MIDSHIP SECTION.

S.S. "Madeline"

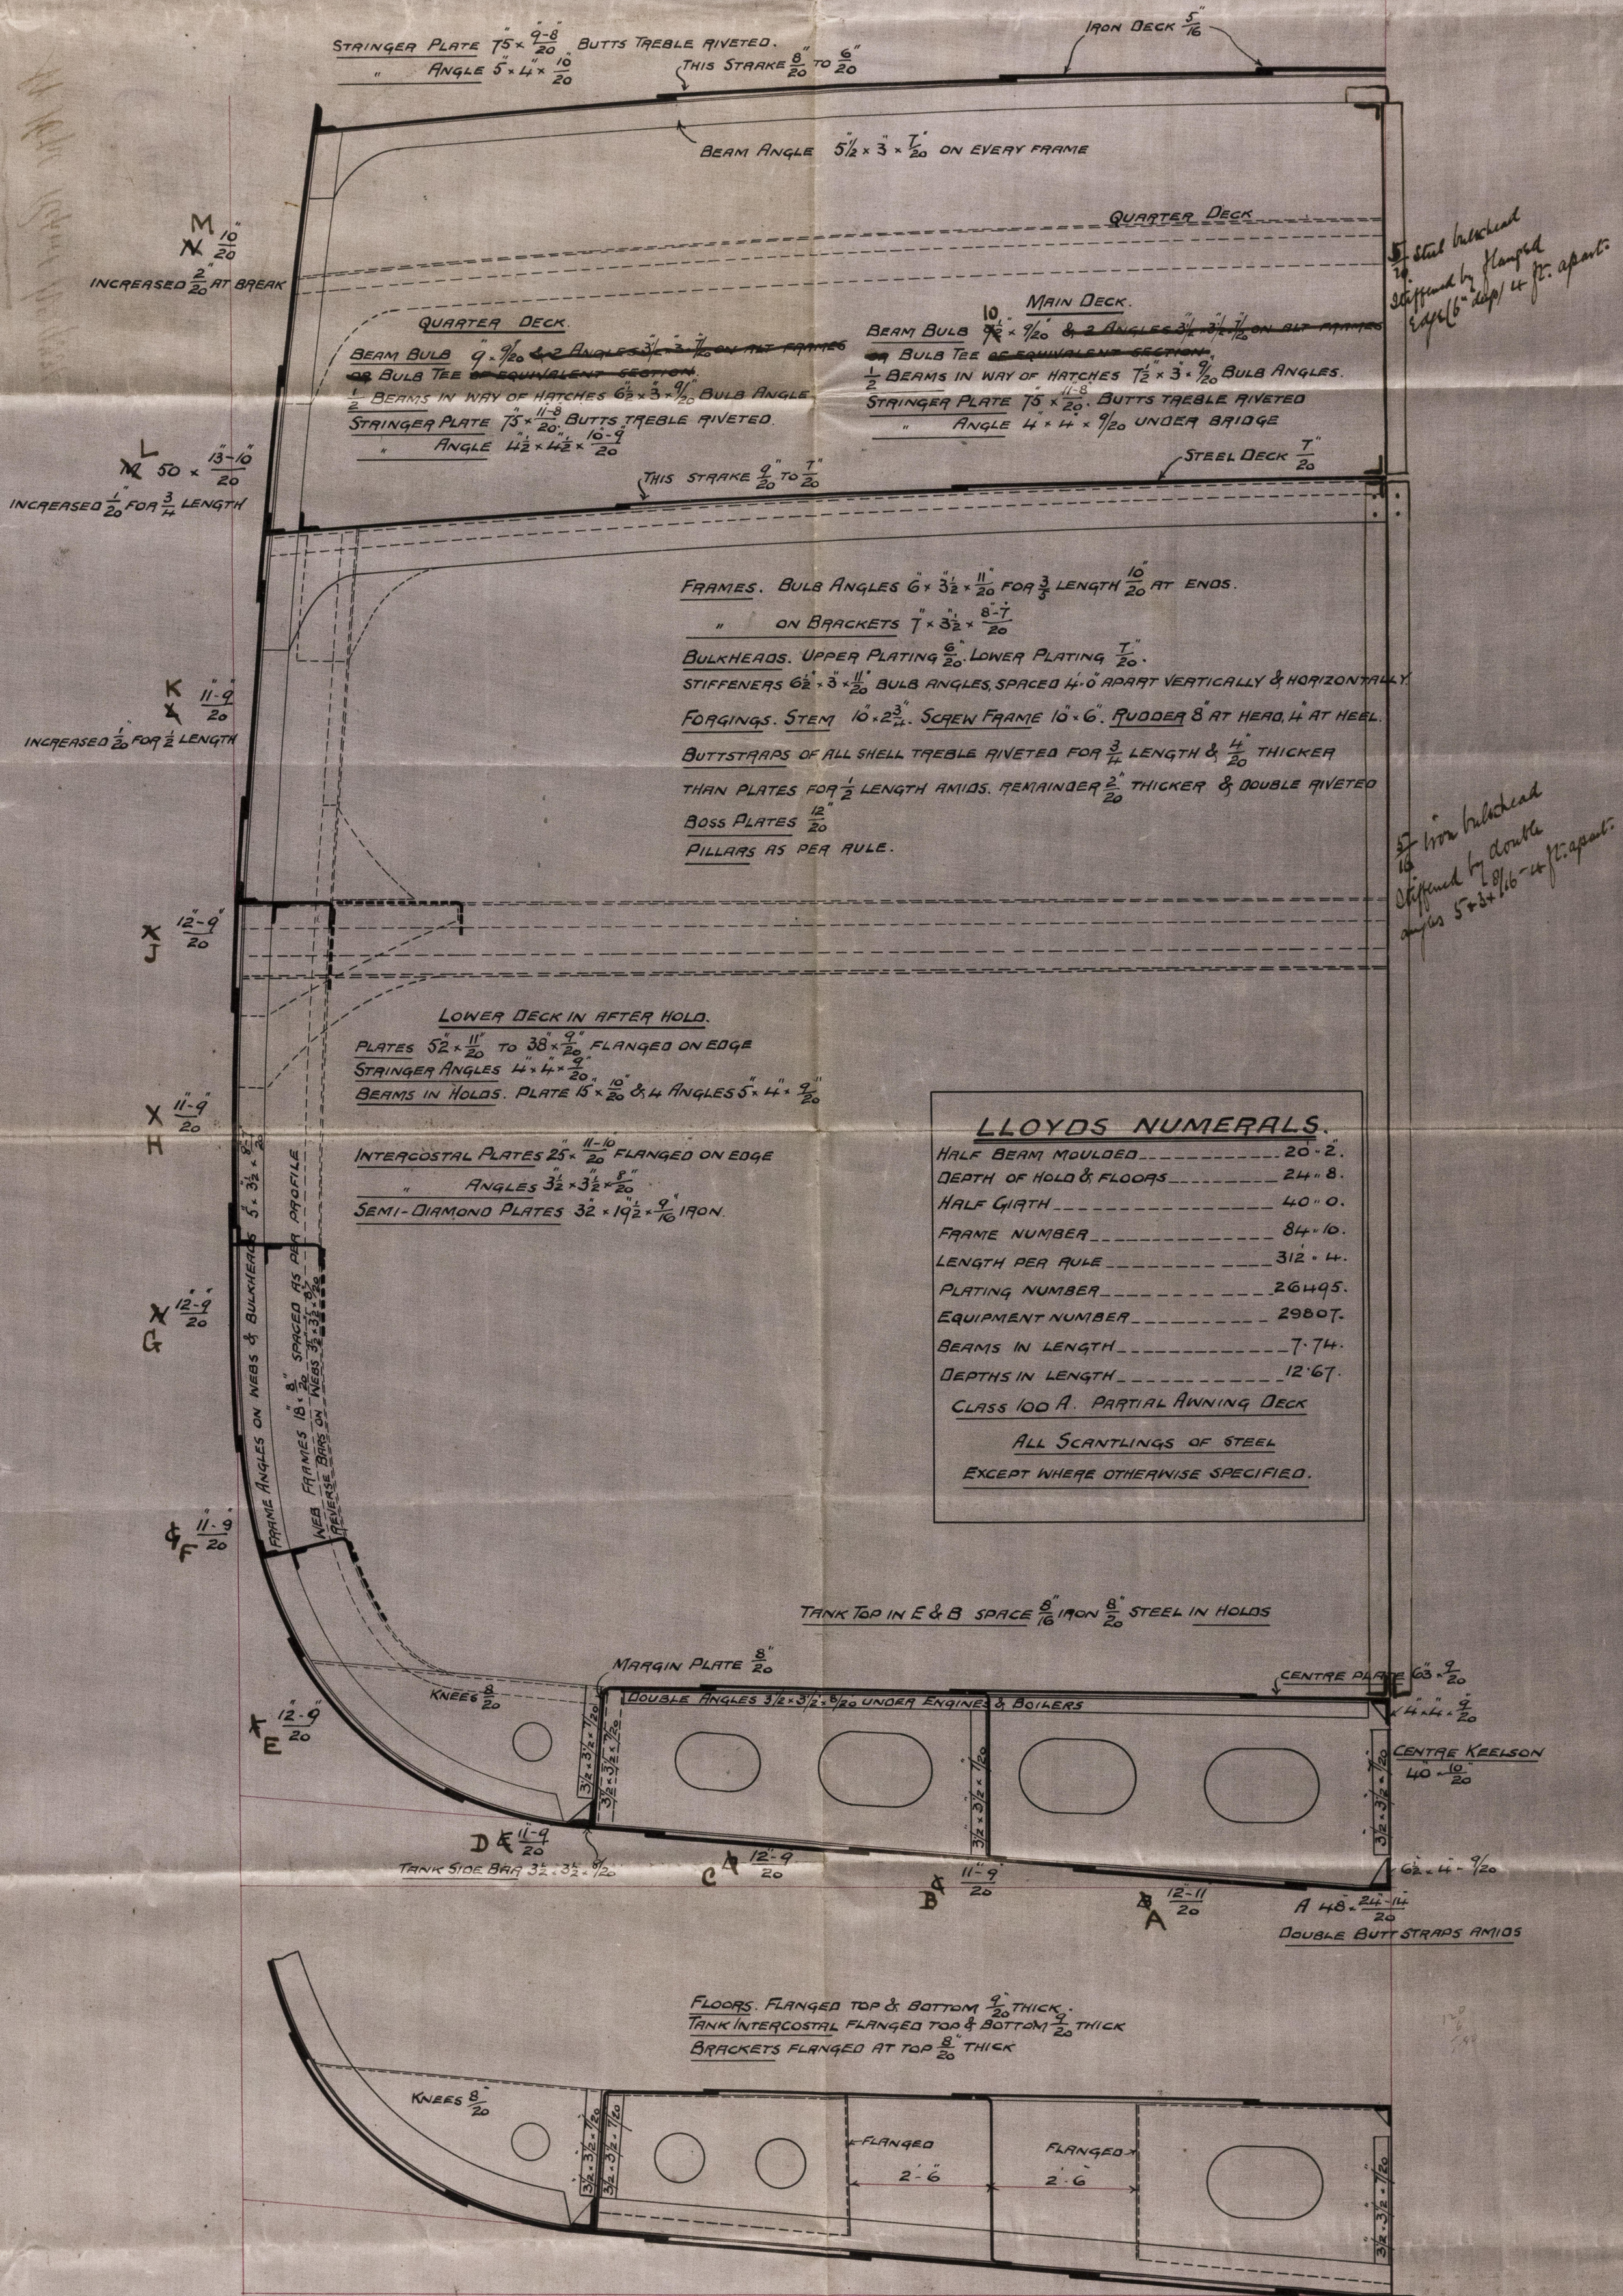

S.S. N<sup>o</sup> 205.

Duplicate of S.S. Empire No. 196.



FURNESS, WITBY & CO., LIMITED.  
SHIPBUILDERS & REPAIRERS.  
WEST HARTLEPOOL.  
TRADE MARK NO. 11924  
MAY 7th 1904.

Lloyd's Register  
HPL372-0040  
Foundation



S.S. "Madeline"

Midship Section

Burness Witting & Co

S.S. No. 205.

W. W. Pl. Report No. 9336

S.S. No. 205

MIDSHIP

HPL372-0040

INCHES 2 1/2 AL B&B&K

STRIPPED PLATE 12 x 10 1/2" BULLS HEADS PLATE 12 x 10 1/2"

Hydra 2 x 1 x 10 1/2"

LINE 2 1/2 x 10 1/2"

Keels B

© 2020

Lloyd's Register  
Foundation

GRAVEL DECK

BEAM BULB 2 1/2 x 10 1/2"