

Lloyd's Register of British and Foreign Shipping.

(Report on Vessel No. 9336 Port WEST HARTLEPOOL.)No. 2637a

SHIP FORGINGS OR CASTINGS.

I have to report that the undermentioned Iron or ~~Steel~~ Forgings or Castings, manufactured by Mfr. J. Richardson & Son of Hartlepool for the Vessel No. 205, being built by Mfr. James Widdie & Co. of Hartlepool have been inspected by me as set forth below, and found to be, so far as can be seen, sound


Mark on Forgings.

Lloyd's

No. 2637a
No. 6.Hugh CameronSunderland
30.12.93

	STERN FRAME.	RUDDER FRAME.	STEM.
Material* ...	<u>Scrap iron</u>	<u>Scrap iron</u>	<u>Scrap iron</u>
How made ...	<u>Forged</u>	<u>Forged</u>	<u>Forged</u>
Dimensions ...	<u>10' x 6"</u>	<u>8' x 4"</u>	<u>10' x 2 3/4"</u>
Progress on Inspection	<u>Forged & milled</u>	<u>Forged & milled</u>	<u>Forged</u>
Date when Inspected	<u>Sept 15th to Oct 5/93</u>	<u>Oct 20th to Dec 11/93</u>	<u>Oct 5/93</u>

SKETCHES OF FRAMES SHOWING POSITION AND DESCRIPTION OF WELDS OF FORGINGS, OR PARTICULARS OF TESTS APPLIED TO CASTINGS.

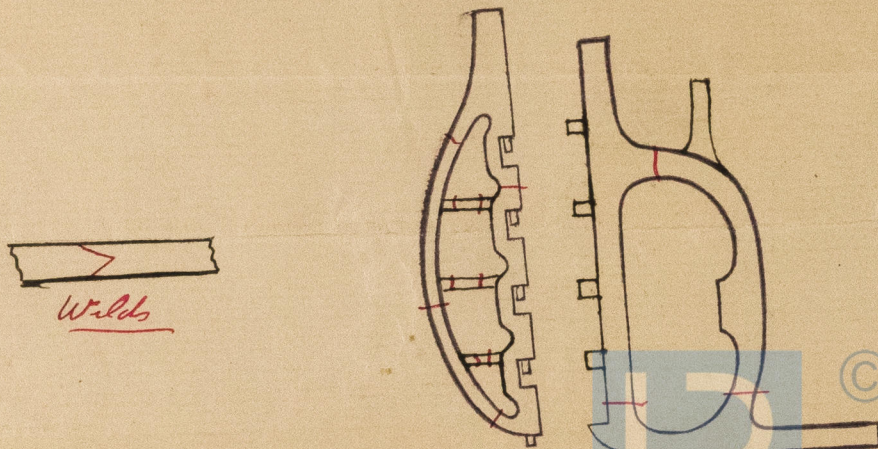

* If of Iron, state whether scrap or puddled Iron.