


MIDSHIP SECTION.

See also to H&L

10.11.93.

18.11.93.

2.4.94

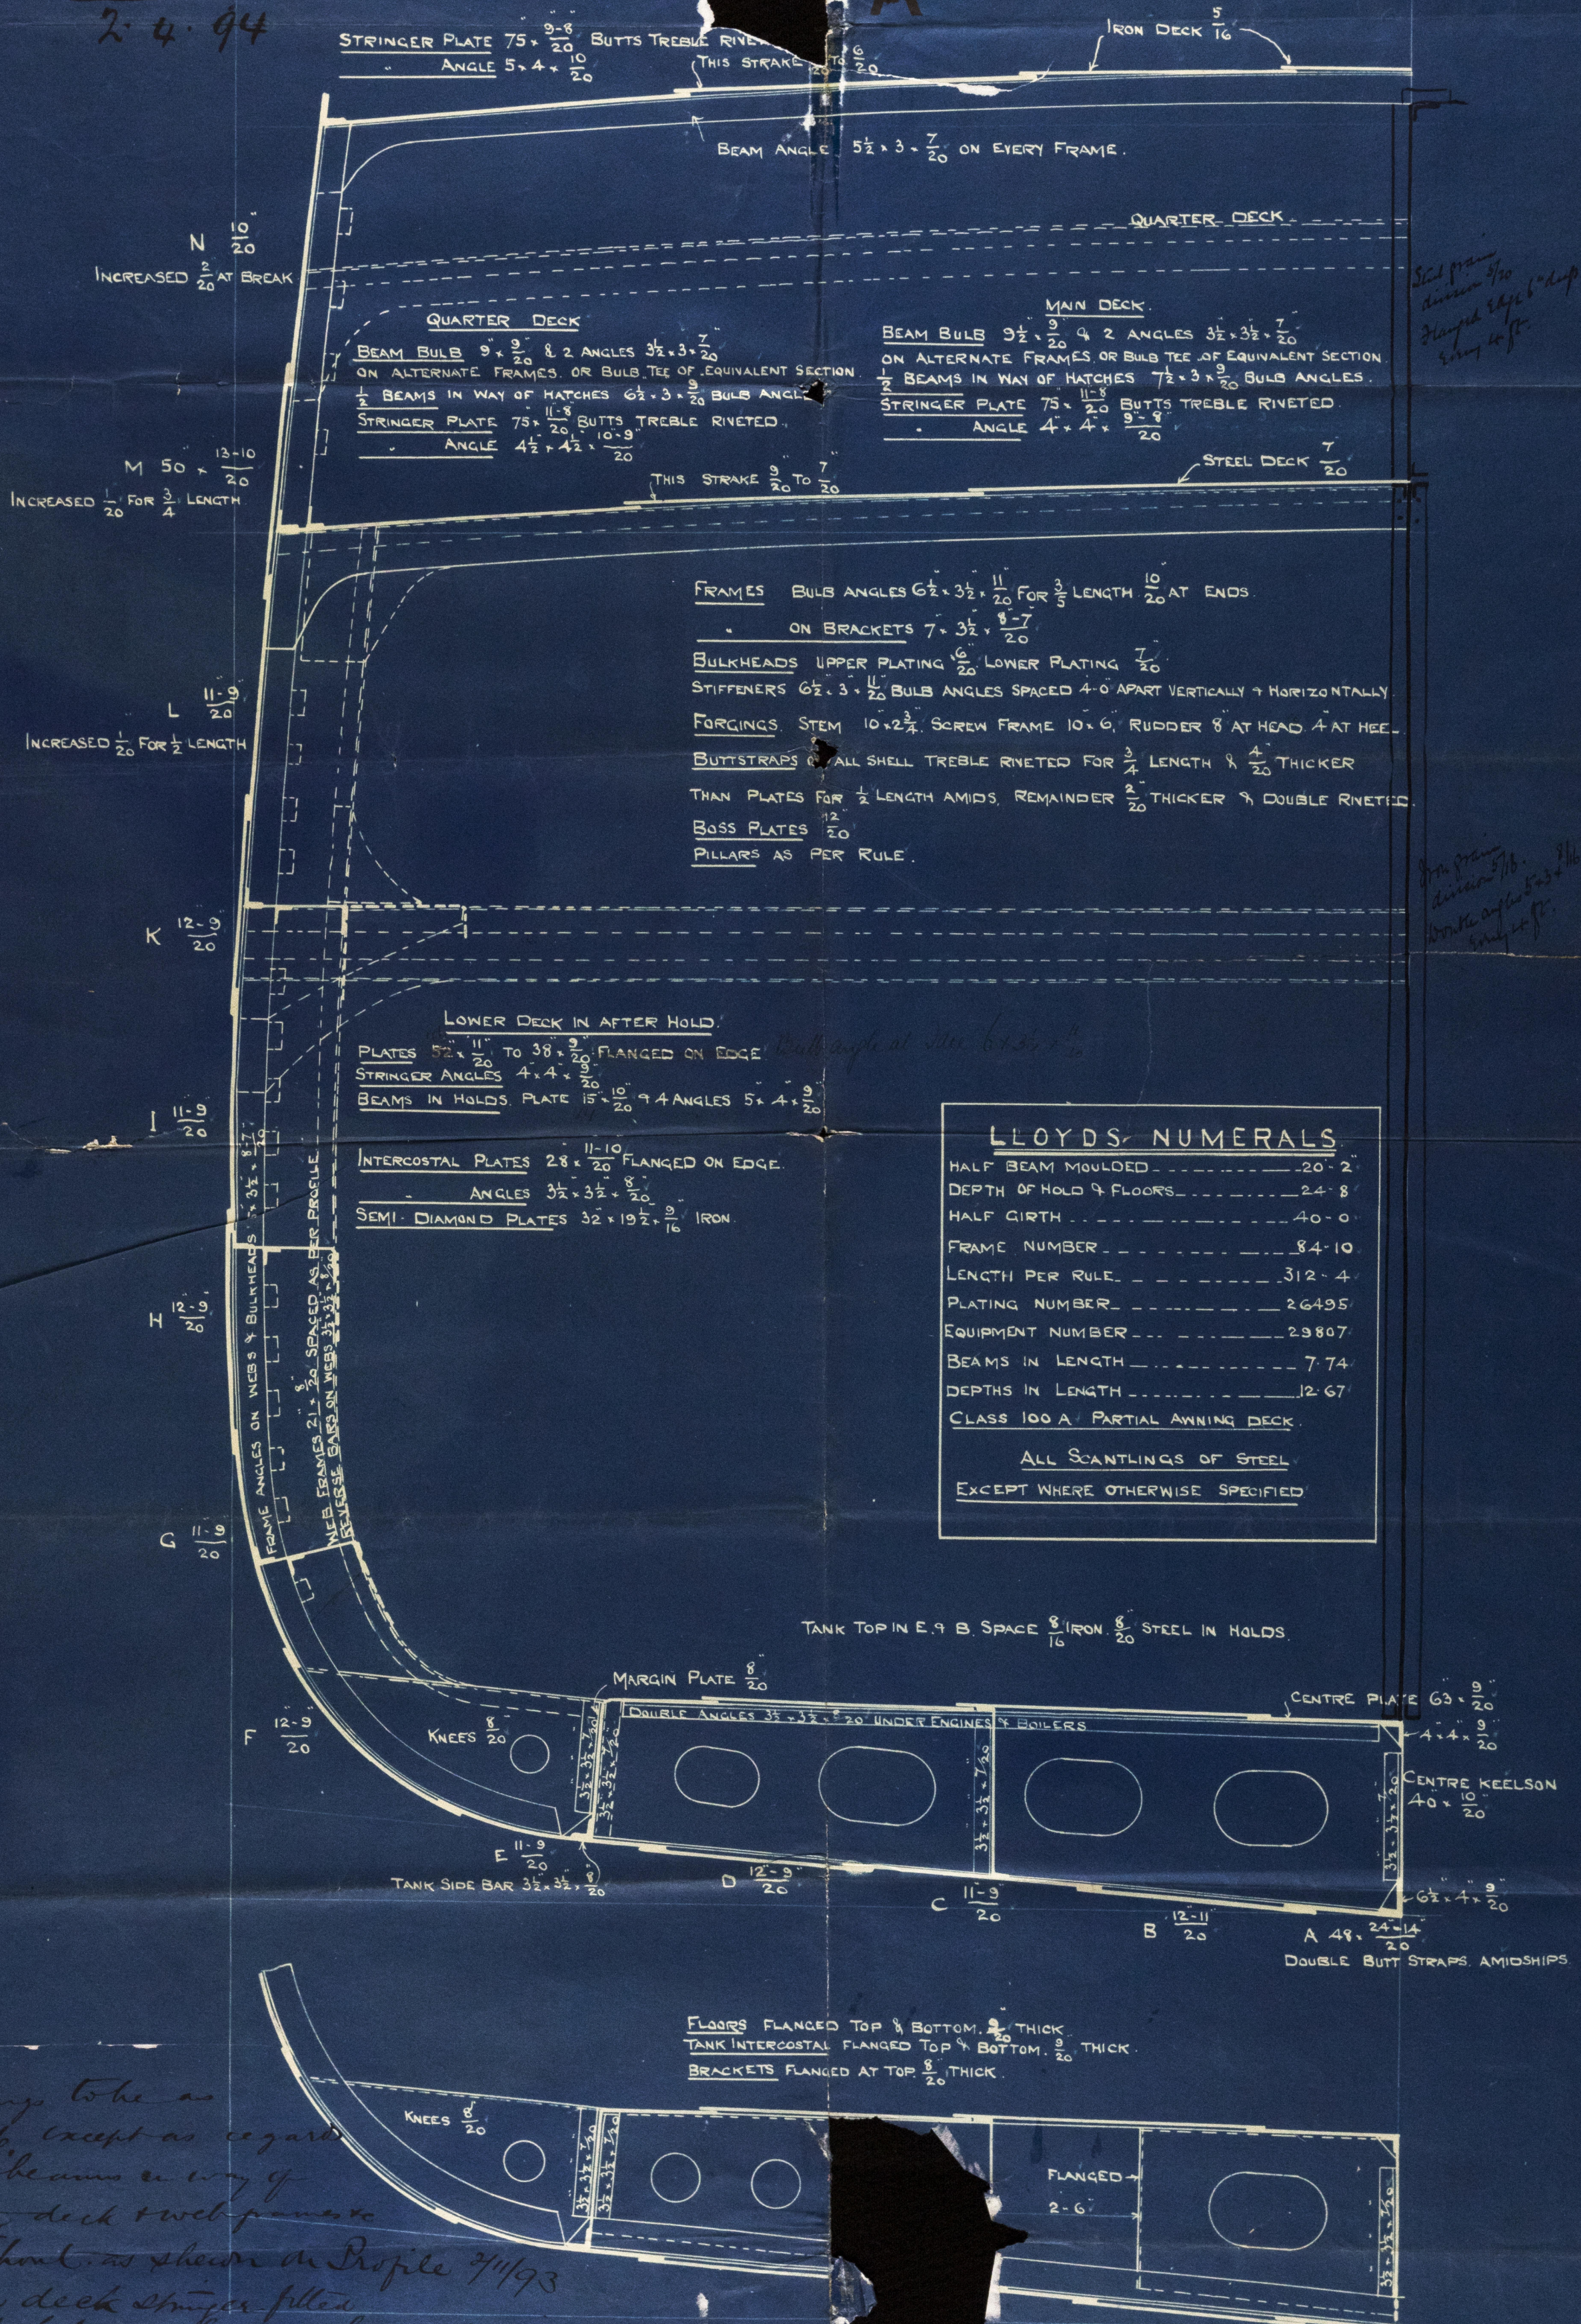

S.S. N° 204.

FURNESS, VINTAGE & CO. LIMITED




MIDSHIP SECTION

WESTMAN PROOF

TRACING N° 11673
OCTOBER 31ST 1893

Nos 204 & 7
Midship Section

A
Furness, Withy & Co.

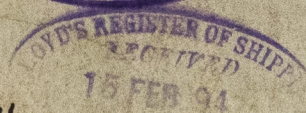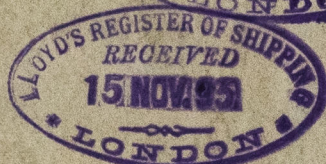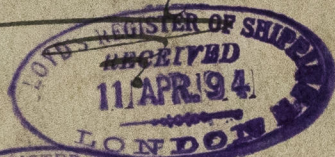


N^o 204-

S. S. Manningtry

H. W. Pl. Repose N^o 9351


11 FEB 94

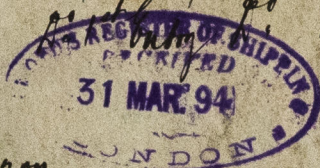

N^o 207-

S. S. Saint Jerome

H. W. Pl. Repose N^o 9424

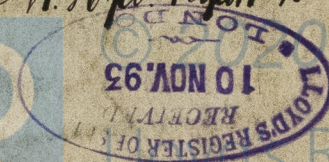

HPL 372-0113



Lloyd's Register
Foundation